


T235 RAW

8123176

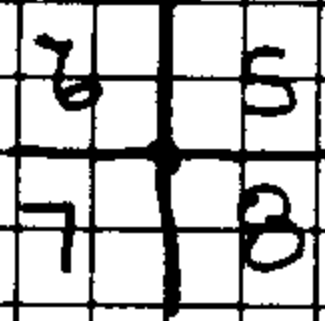

SEE RENEWAL # 45

(1)


FOUND:

A 1" x 1" x 36" "T" IRON SET BY HAINES.  
 A R. CEDAR 21" IN DIAMETER WITH  
 PREVIOUSLY OPENED BLAZES BUT NO  
 VISIBLE SCRIBING. IT BEARS S11E,  
 12.0' AND IS TAGGED WITH LOCATION  
 POSTER. FOUND NO TRACE OF  
 ORIGINAL BEARING TREES.

SET:

A 1" x 30" PIPE WITH BRASS CAP  
 STAMPED "DOUGLAS CO. SURVEYOR"

T235 RAW

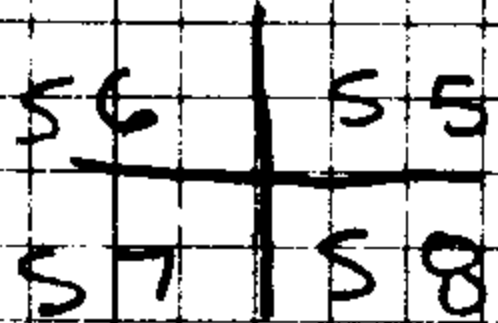

1976

REPLACED "T" IRON DIRECTLY  
 NEXT TO BRASS CAP.


DIETZGEN NO. 385-6

#153 ✓

C.S. File No. 59/18-19 C

T23S RAW

8/23/76

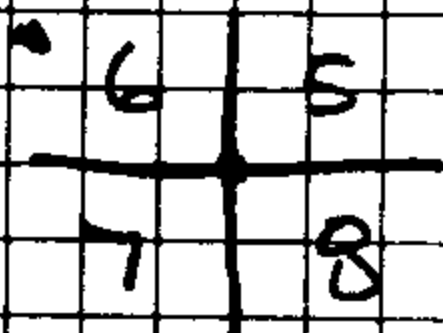

SEE REN. # 45

(2)

NEW TREES:

A 17" CEDAR BEARS N40°E; 17.0'  
MARKED "T23S RAW S5 CS BT" IN  
A DOUBLE BLAZE.

A 23" CEDAR BEARS N72°W; 11.0'  
MARKED "T23S RAW S6 CS BT" IN  
A DOUBLE BLAZE.

A 6" FIR BEARS S85°W; 67.5'  
MARKED "T23S RAW S7 CS BT"  
IN A DOUBLE BLAZE.

A 7" CEDAR BEARS S61/2°E; 36.0'  
MARKED "T23S RAW S8 CS BT"  
IN A DOUBLE BLAZE.

COMPASS DEC. 20°E

*[Signature]*

A. Nita Currie  
Jim Cook

C. S. File No. 59/18-19