

8-25-76

$\frac{1}{4}$ $\frac{23}{26}$ WITNESS CORNER
T23 S R5W

(SEE REN. # 7, 28, AND 48)

FOUND:

A 1" IRON PIPE, FIRMLY SET IN A N-S
FENCE LINE, WITH BRASS CAP ATTACHED,

MARKED:

COUNTY SURVEYOR'S OFFICE

W S23 T23S
C S26 R5W

50' SOUTH TO
 $\frac{1}{4}$ CORNER

1959

FROM WHICH:

A 20" NOW 24" D. FIR BEARS S71°W
17 $\frac{1}{2}$ FT, WELL-HEALED. THIS TREE IS DEAD AND
AT THE LANDOWNER'S REQUEST, WE FELL
THIS TREE LEAVING A FOUR FOOT HIGH
STUMP. THIS TREE IS ALSO THE


#102 ✓

U.S. File No. 59/18-23 PAGE 1 U

DIETZEN NO. 385-6

94
.4
26

$$397 @ 3^{\circ} .9744 = 38^{\circ}$$

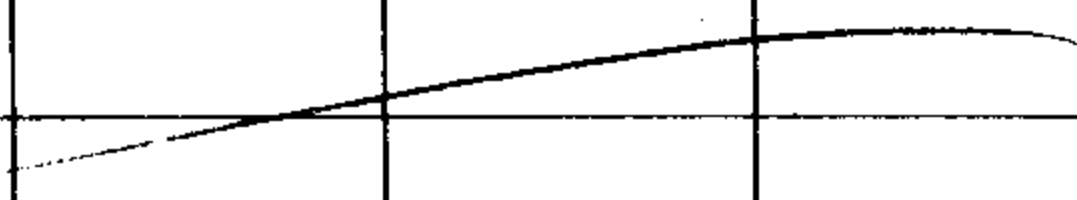

NEW BT 16" D.F.R

~~65~~
S 56° W

80° LVL

PARTIALLY GIRDLED

BGAUNES ON
ENE
NW SIDE

BOTTOM BLAZE BEGINS

1 FOOT ABOVE GROUND

WC 1/4 S 23 CS BT

-NW BEARING TREE MARKED BY BEN B. IRVING
IN 1940 REFERRING TO THE TRUE CORNER
LOCATION. WE DO NOT FIND IRVING'S
CORNER MONUMENT OR HIS SW BEARING
TREE. (SEE RENEWALS #7, 28, 48)

AND A 16" NOW 18" D. FIR ALIVE AND WELL
HEALED BEARS N 12° E 38⁸ FT. FROM THE
WITNESS CORNER. (SEE REN. # 48)

WE MARK A NEW BEARING TREE AS FOLLOWS:

A 16' D. FIR BEARS S 66° W 80² FT.,
SCRIBED "WC 1/4 S 23 CS BT" IN A DOUBLE
BLAZE. THIS TREE HAS BEEN GIRDLED BY
BEAVERS ON THE NW AND NE SIDES. OUR
LOWER BLAZE BEGINS ONE FOOT ABOVE
THE GROUND.

COMPASS DECLINATION SETTING: 20° EAST

8-25-76

OK
[Signature]

[Signature]
MIKE TOMPKINS

C&E File No. 59/18 WITNESS: GEORGE WHITE
-23