


RENEWAL

9-21-76

T 25 S R 2 W

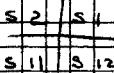

FOUND


U. S. GENERAL LAND OFFICE SURVEY BRASS

1.

CAP, STAMPED:

" " "

T 25 S R 2 W

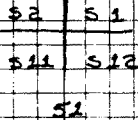

ORIGINAL CORNER STONE SET FIRMLY

ON NORTHWEST EDGE OF CAP. 5 NOTCHES

ON WEST FACE, 1 NOTCH ON SOUTH FACE

A FIR, 48 INCH DIAMETER (NOW A 50 INCH

2.

DIAMETER STUMP) BEARS N 45° E, 7<sup>3</sup>

FEET TO CENTER, 5<sup>6</sup> FEET TO FACE (ORIGINAL

1900 N 30° E, 5<sup>2</sup> FEET; RECORD 1951 N 54<sup>6</sup>° E

7<sup>3</sup> FEET). STUMP HAS WELL HEALED

BLAZE WITH WEYERHAEUSER TAG AND NAIL,

IT DO NOT OPEN FOR SCRIBING.

# 100 ✓

G. S. File No. 59/24

C

DIETZEN NO. 385-6

FOUND

3. AN I. CEDAR 6 NOW 21 INCH DIAMETER,  
BEARS S 65° E, 33° FEET (RECORD/  
1900, S 68° E, 33° FEET, RECORD/  
1951, S 61° E). TREE HAS WELL HEALED  
BLAZE WITH WEYERHAUSER TAG AND  
NAIL, I DO NOT OPEN BLAZE.

4. A D. FIR 36 NOW 42 INCH DIAMETER,  
BEARS N 22° W, 9<sup>1</sup>/<sub>2</sub> FEET TO CENTER,  
(RECORD/1900 N 24° W; RECORD/1951  
N 13° 45' W). TREE HAS WELL HEALED  
BLAZE WITH WEYERHAUSER TAG AND  
NAIL, I DO NOT OPEN BLAZE.

THE S.W. BEARING TREE IS GONE

RENEWAL

A D. FIR, 16 INCHES DIAMETER (BROKEN  
TOP), BEARS S 17 1/2° W, 46<sup>1</sup>/<sub>2</sub> FEET.  
TREE DOUBLE BLAZED AND SCRIBED  
"T 25 S R 2 W S 11 CS BT".

MFB. DEC. 20° E

9-21-76

L.E. MONREAN

P.L. EARLE


C.S. File No. 59/29

DIETZGEN NO. 385-6

# PUBLIC LAND CORNERS

WEYERHAEUSER COMPANY  
SPRINGFIELD BRANCH

TOWNSHIP 25S RANGE 2W  
SECTION 2 CORNER SE  
COUNTY Douglas OREGON

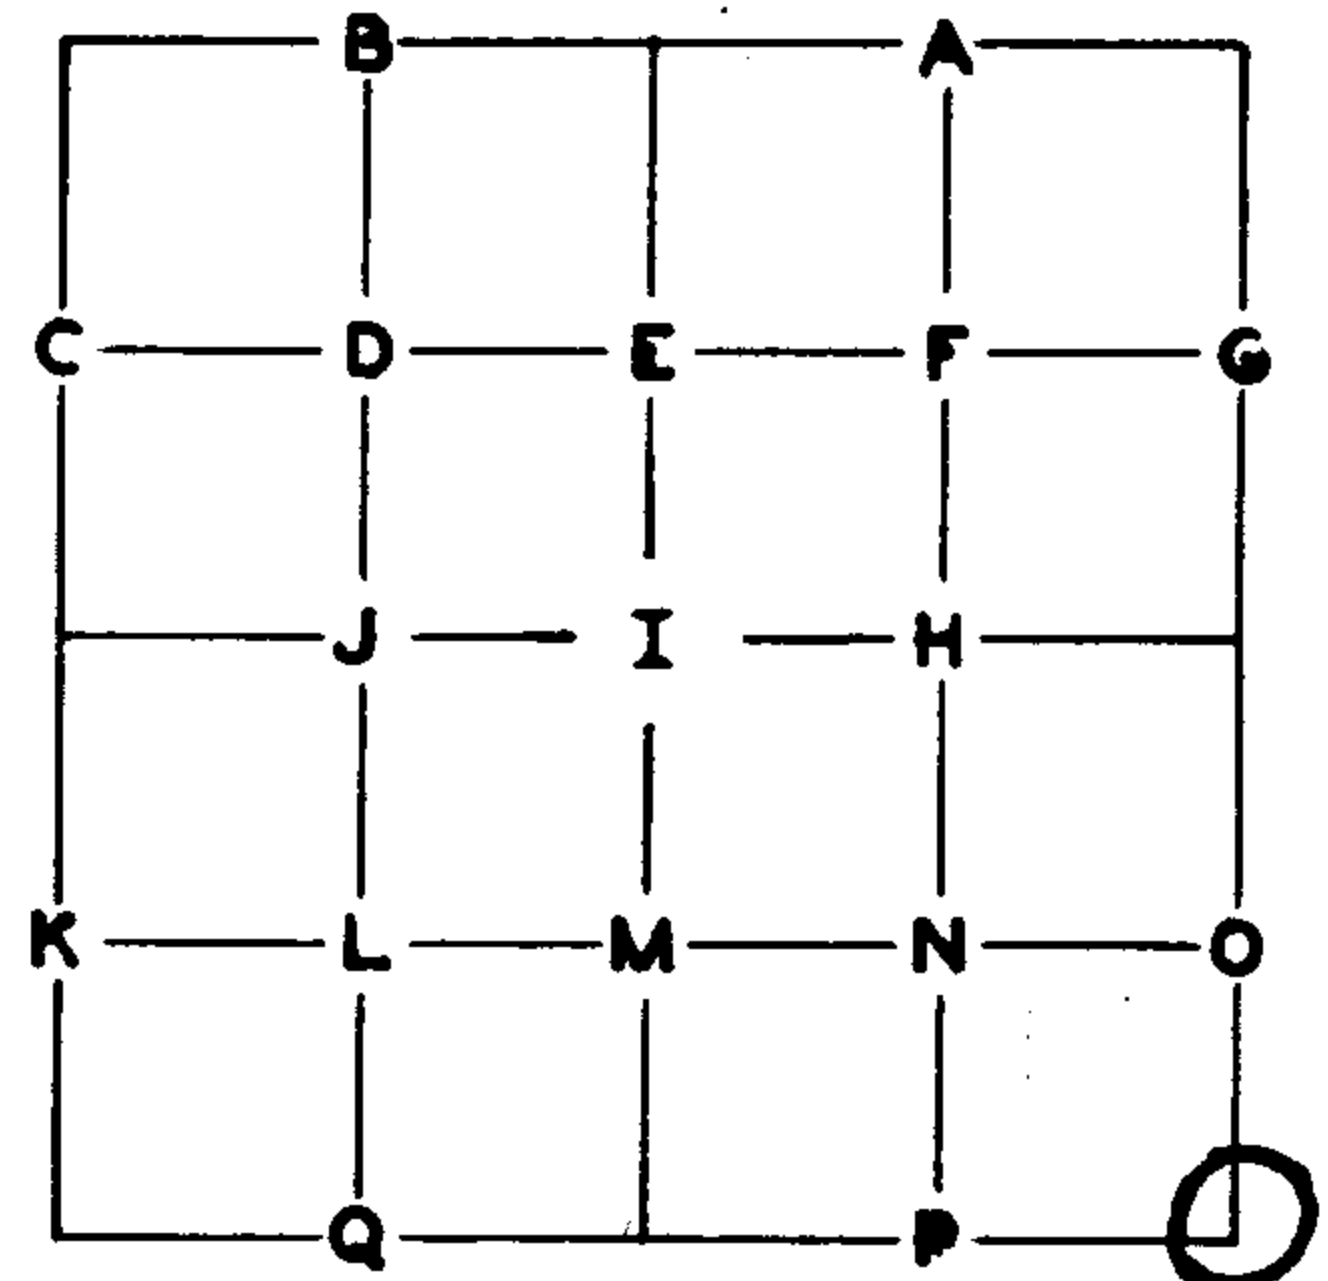

GLO SURVEY RECORD DATE: <u>1900</u> CORNER <u>stone</u>	PRESENT CONDITION - (DESCRIBE FULLY - USE PAGE 2 IF NEEDED FOR EXPLANATION.) <b>Stone at North edge of Brass Cap.</b>
---	---

ACCESSORIES:				
	BEARING-	LINKS-	FEET-	
1) 48" Fir	N30E	9	5.9	54" Fir stump, face overgrown.
2) 6" Cedar	S68E	50	33.0	18" Incense Cedar, face overgrown.
3) 14" Fir	S19 1/2 W	15	9.9	Not found.
4) 36" Fir	N24W	14	9.2	42" Fir, face overgrown-BLM BT tag.

GLO SURVEY RECORD DATE: <u>1951</u> Found original stone and 4 original BT's. Set brass cap and recorded bearings and distances to original BT's:	PRESENT CONDITION: <b>As reported above.</b>
1) 54" Fir N54 1/2 E 11 links, 7.3'	"
2) 10" Cedar S61E 50 links, 33.0'	"
3) 20" Fir S11 1/2 W 17 links, 11.2'	"
4) 40" Fir N13-3/4W 14 links, 9.2'	"

CORNER SET: Brass cap as set by US GLO 1951 MAG. DECL.: 20°  
 with original stone alongside to North.

BEARING AND DISTANCE TO ABOVE IDENTIFIED SURVEY ACCESSORIES:

BEARING-	FEET-	SURVEY -	
1) N45E	7.2	1900	Distance measured to center of stump.
2) S65E	33.2	1900	Distance measured to center of tree.
3) nothing at either 1900 or 1951 bearing or distance (nothing found).			
4) N23W	9.6	1900	Distance measured to center of tree.

ACCESSORIES ADDED THIS DATE:

MAGNETIC DECLINATION 20°

	BEARING	FEET	ORIG. B.T.	'W' NAIL	PLATE	BRASS DISC
1) 54" Fir Stump	N45E	5.6	X	X	X	--
40" Fir Stump	N64E	60.1	--	X	X	--
2) 18" Incense Cedar	S65E	32.1	X	X	X	--
4) 54" Fir	N23W	7.5	X	X	X	--

IDENTIFIED ON PHOTO:

INFORMATION ON LOCATION OF CORNER AS NOW SET:

GROUND COVER: Shale rock slope

(USING FORM LINES SKETCH TOPOG AT CORNER ON PAGE 2 PLAT)

SLOPE FACES (GIVE BEARING IN DEGREES) S20E ON MINUS (-) 75 %

NORTH: +70% logged to East, old growth to West soon to be logged.

SOUTH: -60% logged to East and West.

EAST: -25% - Old logging to North and South.

WEST: +35% 150' - Logged to South, soon to be logged to North.  
Scattered residual trees to South.

WORK DONE FOR W. CO.

FIELD NOTES IN BOOK:

BY: Glen McChesney DATE: 2/13/75  
PROJECT ENGINEER - ~~SURVEYOR~~

ASSISTED BY:

COPIES SENT TO:

UNDER THE SUPERVISION OF:


REGISTERED  
PROFESSIONAL  
LAND SURVEYOR

*Frank D. Williams*

OREGON  
JULY 22, 1969  
FRANK D. WILLIAMS  
0075


SEAL  
C.S. File No. 59/27

SECTION 2 TOWNSHIP 25S RANGE 2W

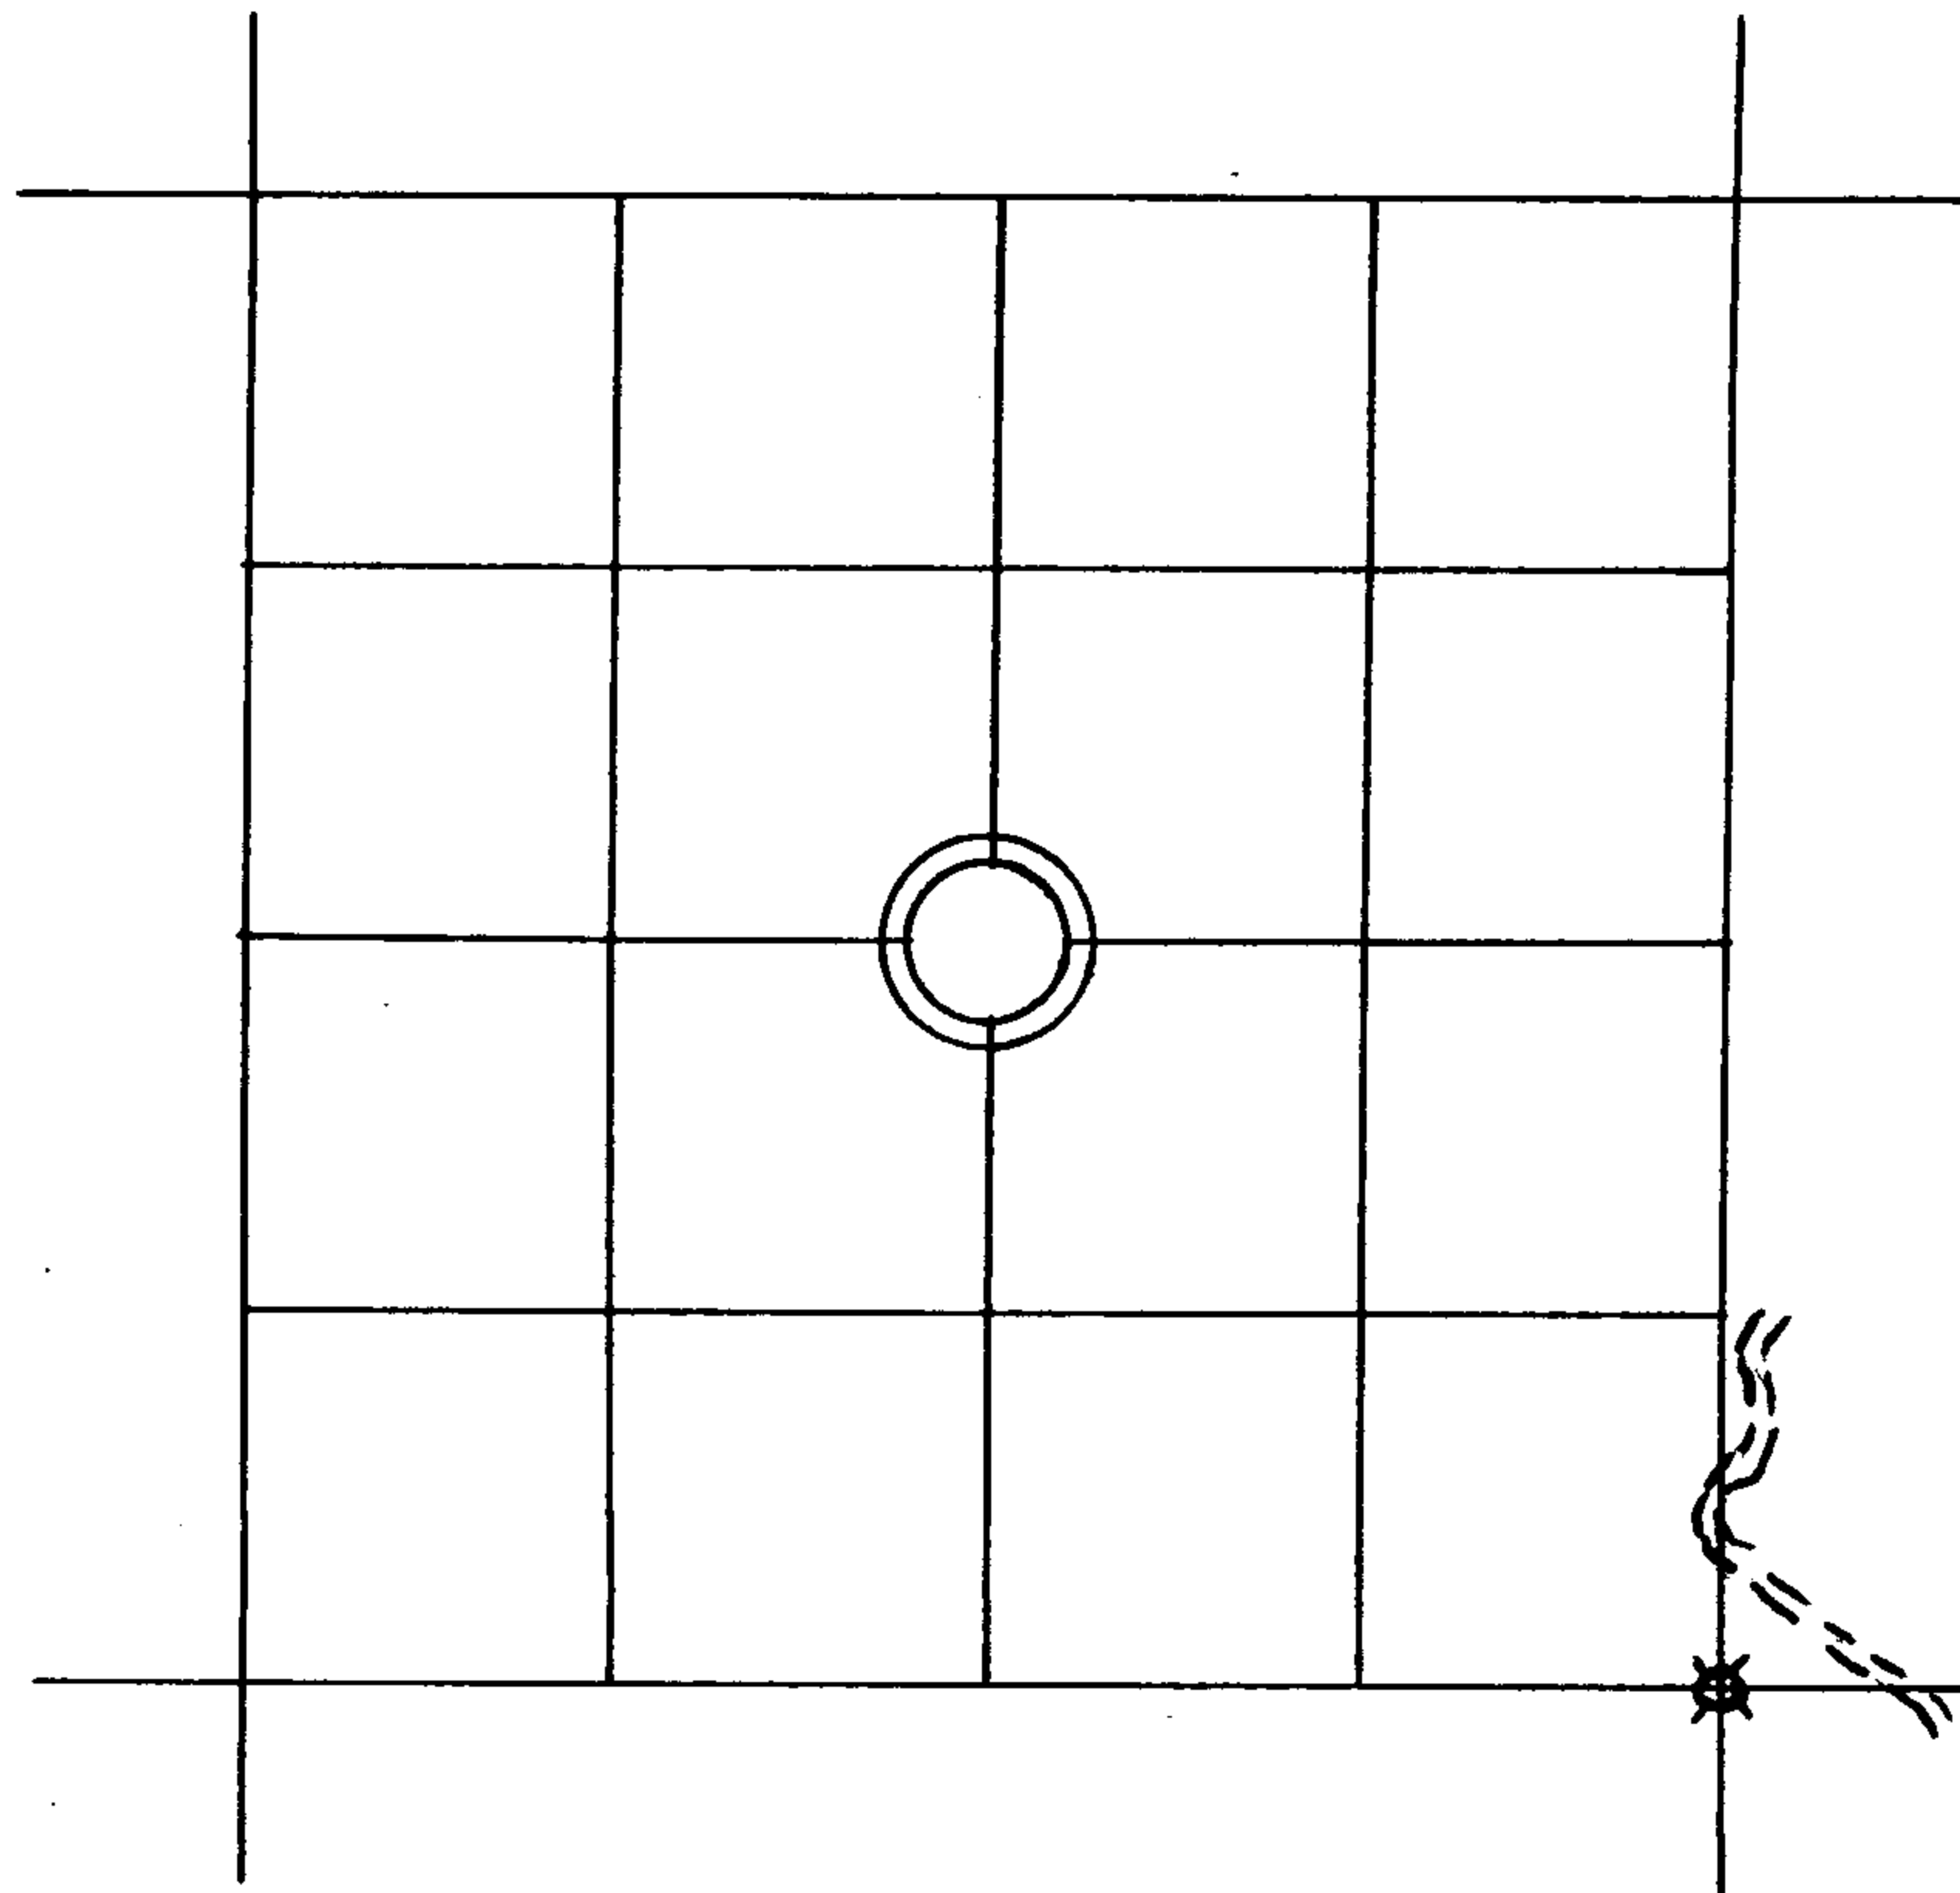

 LINE MARKED BY NOTCH CUT IN BLAZE.

 ...KNOWN CORNER.

 ...REFERENCED CORNER  
BY WEYERHAEUSER  
METHOD.

The GLO 1951 renewal noted differences in bearings and distances from the GLO 1900 record. Please note differences found by me, particularly in bearings, from both the above records.

	31	32	33	34	35	36	31
1	6	5	4	3	2	1	6
12	7	8	9	10	11	12	7
13	18	17	16	15	14	13	18
24	19	20	21	22	23	24	19
25	30	29	28	27	26	25	30
36	31	32	33	34	35	36	31
1	6	5	4	3	2	1	6

0812  
 STATE OF OREGON  
 1978 15 1988  
 OREGON

0812  
 STATE OF OREGON  
 1978 15 1988  
 OREGON

## WEYERHAEUSER COMPANY

CORNER REFERENCE METHOD CONSISTS OF:

A "W" NAIL DRIVEN THRU THE HOLE IN A BRASS DISC, INTO A NOTCH CUT LOW ON A TREE, STAMPED WITH THE OREGON REGISTERED LAND SURVEYOR OR PROFESSIONAL ENGINEER REGISTRATION NUMBER.

AN EMBOSSED ALUMINUM PLATE, NAILED HEAD HIGH ON SAME TREE WITH 8D ALUMINUM NAILS, WITH DISTANCE AND BEARING FROM THE "W" NAIL TO THE CORNER STAMPED ON IT.

