

9-1-76

S16 | S15 T24S R2W

K
4

FOUND

AN ORIGINAL BEARING TREE, A 60" D. FIR, NOW
A 60" STUMP, WITH SCRIBING "1/4 S" VISIBLE
ON PREVIOUSLY OPENED BLAZE. KING
COUNT INDICATES APPROX. 80 YEARS OF
GROWTH AND SIX INCH INCREASE IN
DIAMETER.

WE DO NOT FIND ANY EVIDENCE OF
THE ORIGINAL NW BEARING TREE OR
THE ORIGINAL CORNER MONUMENT.

AT THE TRUE CORNER POINT AS DETERMINED
BY THE RECORD BEARING AND DISTANCE,
N 10° E 14³/₄ FT TO THE FOUND OBJ.,

WE SET:

A 1" X 30" IRON PIPE, 26" IN THE GROUND,
WITH BRASS CAP ATTACHED,

#91 ✓

132
12

145

166
22

132
182

1452

S 78° W

S 82° W 90 FT

W-NAIL 72

42" D. FIRE STUMP

DBT

N 10° E 14 E "1/4 S" N 181545

W-112 N 10° E

DOUGLAS COUNTY SURVEYOR

T24S R2W

S16 | S15

1/4

1976

FROM WHICH WE NOTE THE FOLLOWING
BEARING OBJECTS:

A "WEYERHAEUSER NAIL" DRIVEN IN A NOTCH
ON THE FACE OF THE ORIGINAL BT
STUMP BEARS N10°E 11¹/₂ FT.

AND A 42" D. FIR STUMP BEARS S78°W
9¹/₂ FT. ("WEYERHAEUSER NAIL" IN THIS
STUMP BEARS S82°W 7¹/₂ FT.)

WE ALSO FIND AN UNRECORDED $\frac{3}{4}$ " X 30"
ALUM. PIPE AT CORNER POINT. WE PLACE IT
ALONGSIDE THE BRASS CAP.

COMPASS DECLI:

9-1-76

MIKE TOMPKINS

20° EAST
C.S. File No.


59/2-2

any of hanging off
ok

PUBLIC LAND CORNERS

WEYERHAEUSER COMPANY
 SPRINGFIELD BRANCH

TOWNSHIP 24S RANGE 2W
 SECTION 15 CORNER W $\frac{1}{2}$
 COUNTY Douglas OREGON

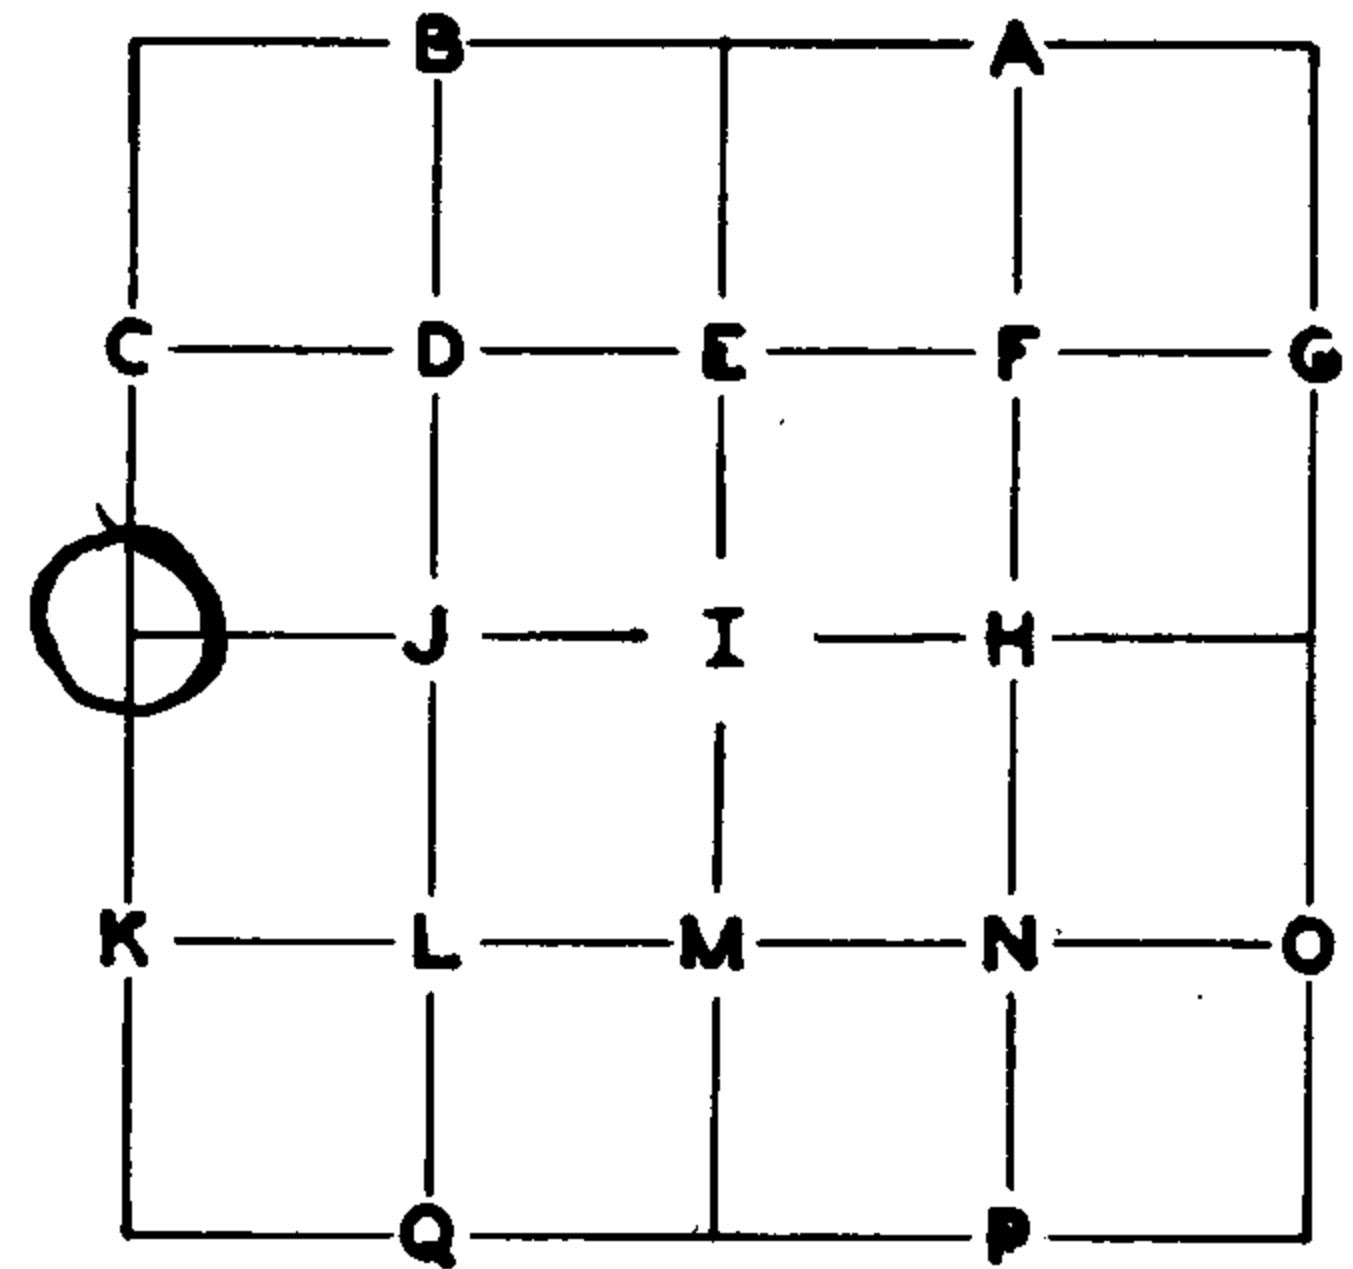

GLO SURVEY RECORD

DATE: September 18, 1894
 CORNER 3'x3"x3" Fir Post

PRESENT CONDITION - (DESCRIBE FULLY -
 USE PAGE 2 IF NEEDED FOR EXPLANATION.)

No trace

ACCESSORIES:

	BEARING-	LINKS-	FEET-	
60' Fir	N10E	22	14.5	72" Fir scribing visible
24" Hemlock	N13W	40	26.4	1 ^o rotten stump

SURVEY RECORD

DATE: _____

PRESENT CONDITION: _____

CORNER SET: 2"x2"x48" Yew Wood Post

MAG. DECL.: 20° E

BEARING AND DISTANCE TO ABOVE IDENTIFIED SURVEY ACCESSORIES:

BEARING-	FEET-	SURVEY -	

22 11

ACCESSORIES ADDED THIS DATE:

MAGNETIC DECLINATION

20° E

	BEARING	FEET	ORIG. B.T.	"W" NAIL	PLATE	BRASS DISC
48" Fir	S80W	7 ⁷	--	X	X	--
72" Fir	N8½E	11 ⁴	X	X	X	--

IDENTIFIED ON PHOTO:

INFORMATION ON LOCATION OF CORNER AS NOW SET:

GROUND COVER: Old growth fir, hemlock

(USING FORM LINES SKETCH TOPOG AT CORNER ON PAGE 2 PLAT)

SLOPE FACES (GIVE BEARING IN DEGREES) N65E ON MINUS (-) 64 %

NORTH: -22% 30 ^{0'} then steeper

SOUTH: + 5% 30 ^{0'} then steeper

EAST: -60%

WEST: +25% 70 ^{0'} to ridge top

FROM CORNER -

WORK DONE FOR W. CO.

FIELD NOTES IN BOOK:

BY: Ken Perkins DATE: May 26, 1972
ENGINEER - SURVEYOR

ASSISTED BY: Len Wilson
Ken Kanoff

UNDER THE SUPERVISION OF:

COPIES SENT TO:

SEAL

PAGE 3

C.S. File No. 59/24-2

36	31	32	33	34	35	36	31
1	6	5	4	3	2	1	6
12	7	8	9	10	11	12	7
13	18	17	16	15	14	13	18
24	19	20	21	22	23	24	19
25	30	29	28	27	26	25	30
36	31	32	33	34	35	36	31
1	6	5	4	3	2	1	6

WEYERHAEUSER COMPANY

CORNER REFERENCE METHOD CONSISTS OF:

A "W" NAIL DRIVEN THRU THE HOLE IN A BRASS DISC, INTO A NOTCH CUT LOW ON A TREE, STAMPED WITH THE OREGON REGISTERED LAND SURVEYOR OR PROFESSIONAL ENGINEER REGISTRATION NUMBER.

AN EMBOSSED ALUMINUM PLATE, NAILED HEAD HIGH ON SAME TREE WITH 8D ALUMINUM NAILS, WITH DISTANCE AND BEARING FROM THE "W" NAIL TO THE CORNER STAMPED ON IT.

