

FOUND

4. A YEW 5 INCHES DIAMETER (NOW A STUMP 6 INCHES DIAMETER) BEARS S 86° E, 14 1/2 FEET (RECORD 3 S 88° E, 14 1/2 FT, HAS BEEN HIT BY LOG. STUMP IS VERY LOOSE.) STUMP SCRIBED " 1/4 S 3 BT "

NOTE: ORIGINAL 6 INCH HEMLOCK IN NE QUAD NOW GONE

BEARING TREES PER RENEWAL 42

5. 6 INCH YEW BEARING N 10° E, 25 1/2 FEET HAS BEEN PUSHED OVER BY CAT LOGGING.

6. A R. CEDAR 16 NOW 18 INCH DIAMETER, BEARS S 6° E, 31 1/2 FEET. TREE DOUBLE BLAZED AND SCRIBED " 1/4 S 3 CS BT "

RENEWAL

1. A R. CEDAR 15 INCH DIAMETER BEARS N 79 1/2° E, 23 1/2 FEET. TREE DOUBLE BLAZED, SCRIBED " 1/4 S 34 CS BT "

MAG. DEC, 20° E

9-20-76

L.R. MORGAN
P.L. EARLE

C.S. File No. 59/2424

DIETZEN NO. 385.6

T 25 S R 3 W

1/4 S 34
S 3

T 26 S

SEE RENEWAL # 12 - T 25-3
12 - T 26-3

FOUND

U.S. GENERAL LAND OFFICE BRASS CAP

1. STAMPED

"

"

1/4 S 34
S 3

19 43

2. A R. CEDAR 4 NOW 17 INCHES DIAMETER

BEARS S 17° W, 2 1/2 FEET. TREE

HAS WELL HEALED BLAZE, I DO NOT

OPEN.

3. A FIR 4 5 1/2" (NOW A 56 INCH DIAMETER

STUMP) BEARS N 15° W, 15 1/2 FEET.

STUMP HAS A WELL HEALED BLAZE,

I DO NOT OPEN.

#135-T25-3 ✓

#206-T26-3 ✓


G. S. File No. 59/24 C

DIETZGEN NO. 385-6

PUBLIC LAND CORNERS

WEYERHAEUSER COMPANY
 SPRINGFIELD BRANCH

TOWNSHIP 25S RANGE 3W
 SECTION 34 CORNER S½
 COUNTY Douglas OREGON

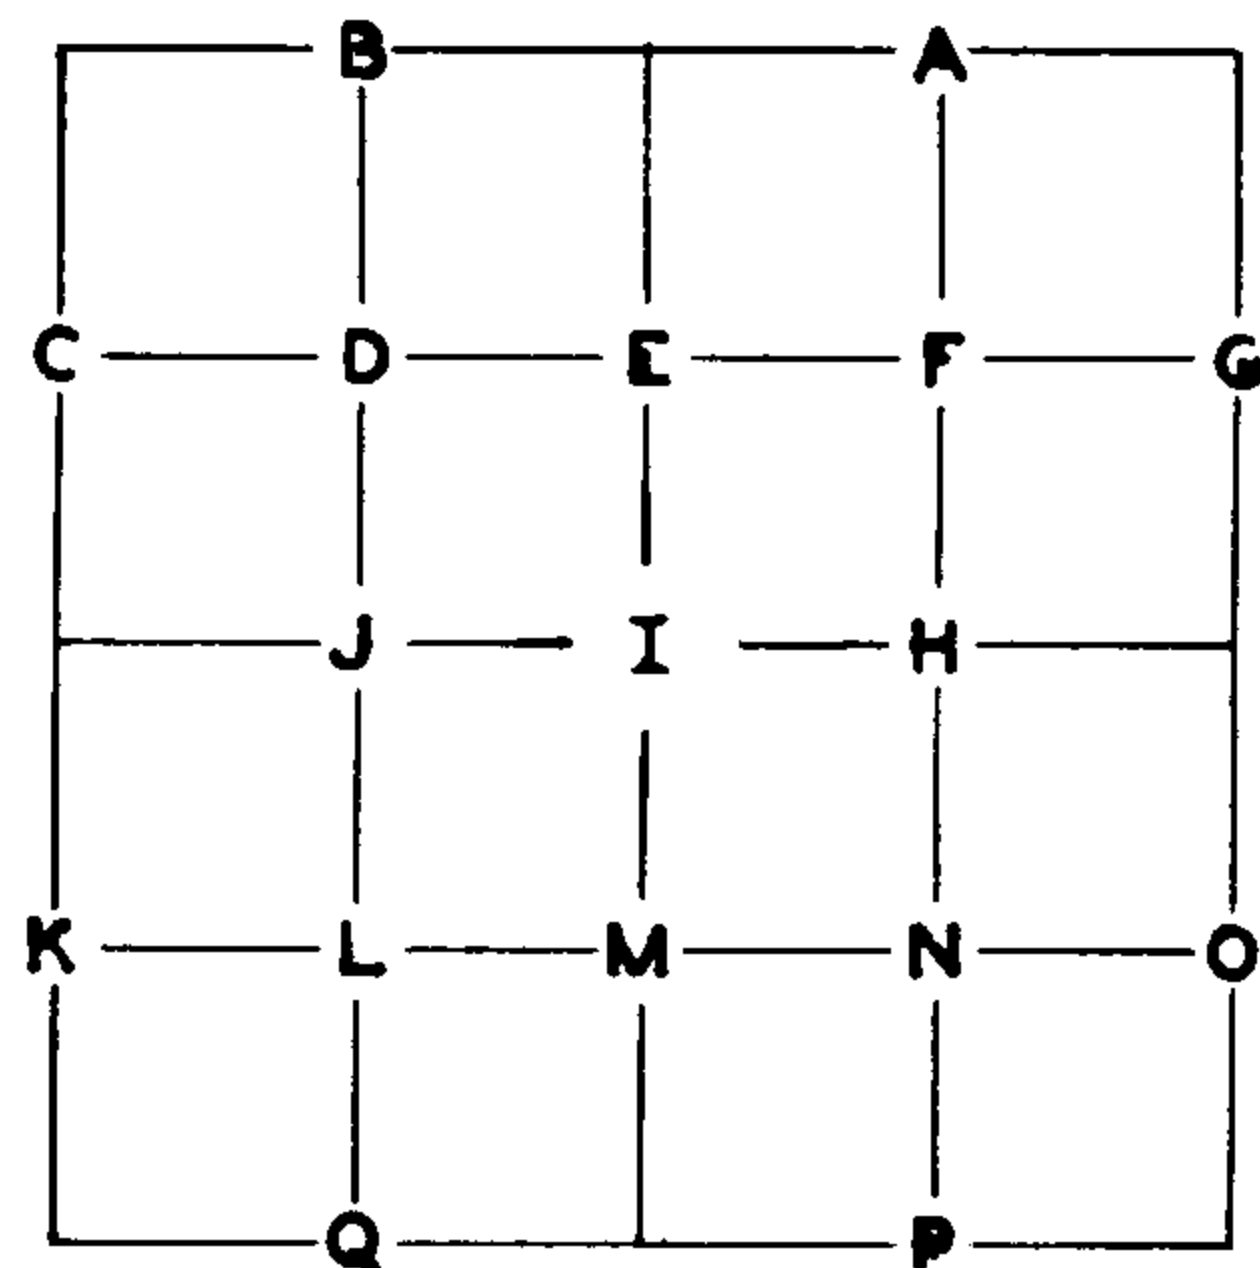

GLO SURVEY RECORD

DATE: March 1, 1955

CORNER Cedar Stake 36"x4"x4"

PRESENT CONDITION - (DESCRIBE FULLY -
 USE PAGE 2 IF NEEDED FOR EXPLANATION.)

Gone

ACCESSORIES:

| | BEARING- | LINKS- | FEET- | |
|-----------------|----------|--------|-------|------------------|
| 6" Hemlock stub | N54½E | 22 | 14.5 | No trace |
| 16" R. Cedar | S17W | 4 | 2.6 | Face healed over |

Douglas County SURVEY RECORD
 DATE: 1943

PRESENT CONDITION: _____

| | | | |
|--------------|--------|-------|---------------------------------|
| 54" Fir N15W | 23lks. | 15.2' | 3' high stump - face grown over |
| 5" Yew S88E | 22lks. | 14.5' | 3' high stub - scribing visible |


CORNER SET: Brass cap (1943)

MAG. DECL.: 20° E

BEARING AND DISTANCE TO ABOVE IDENTIFIED SURVEY ACCESSORIES:

| BEARING - | FEET - | SURVEY - | |
|-----------|--------|----------|-----------------------------|
| S85E | 14.4 | 1943 | Face measurement (Yew stub) |

SECTION 34 TOWNSHIP 15S RANGE 3W

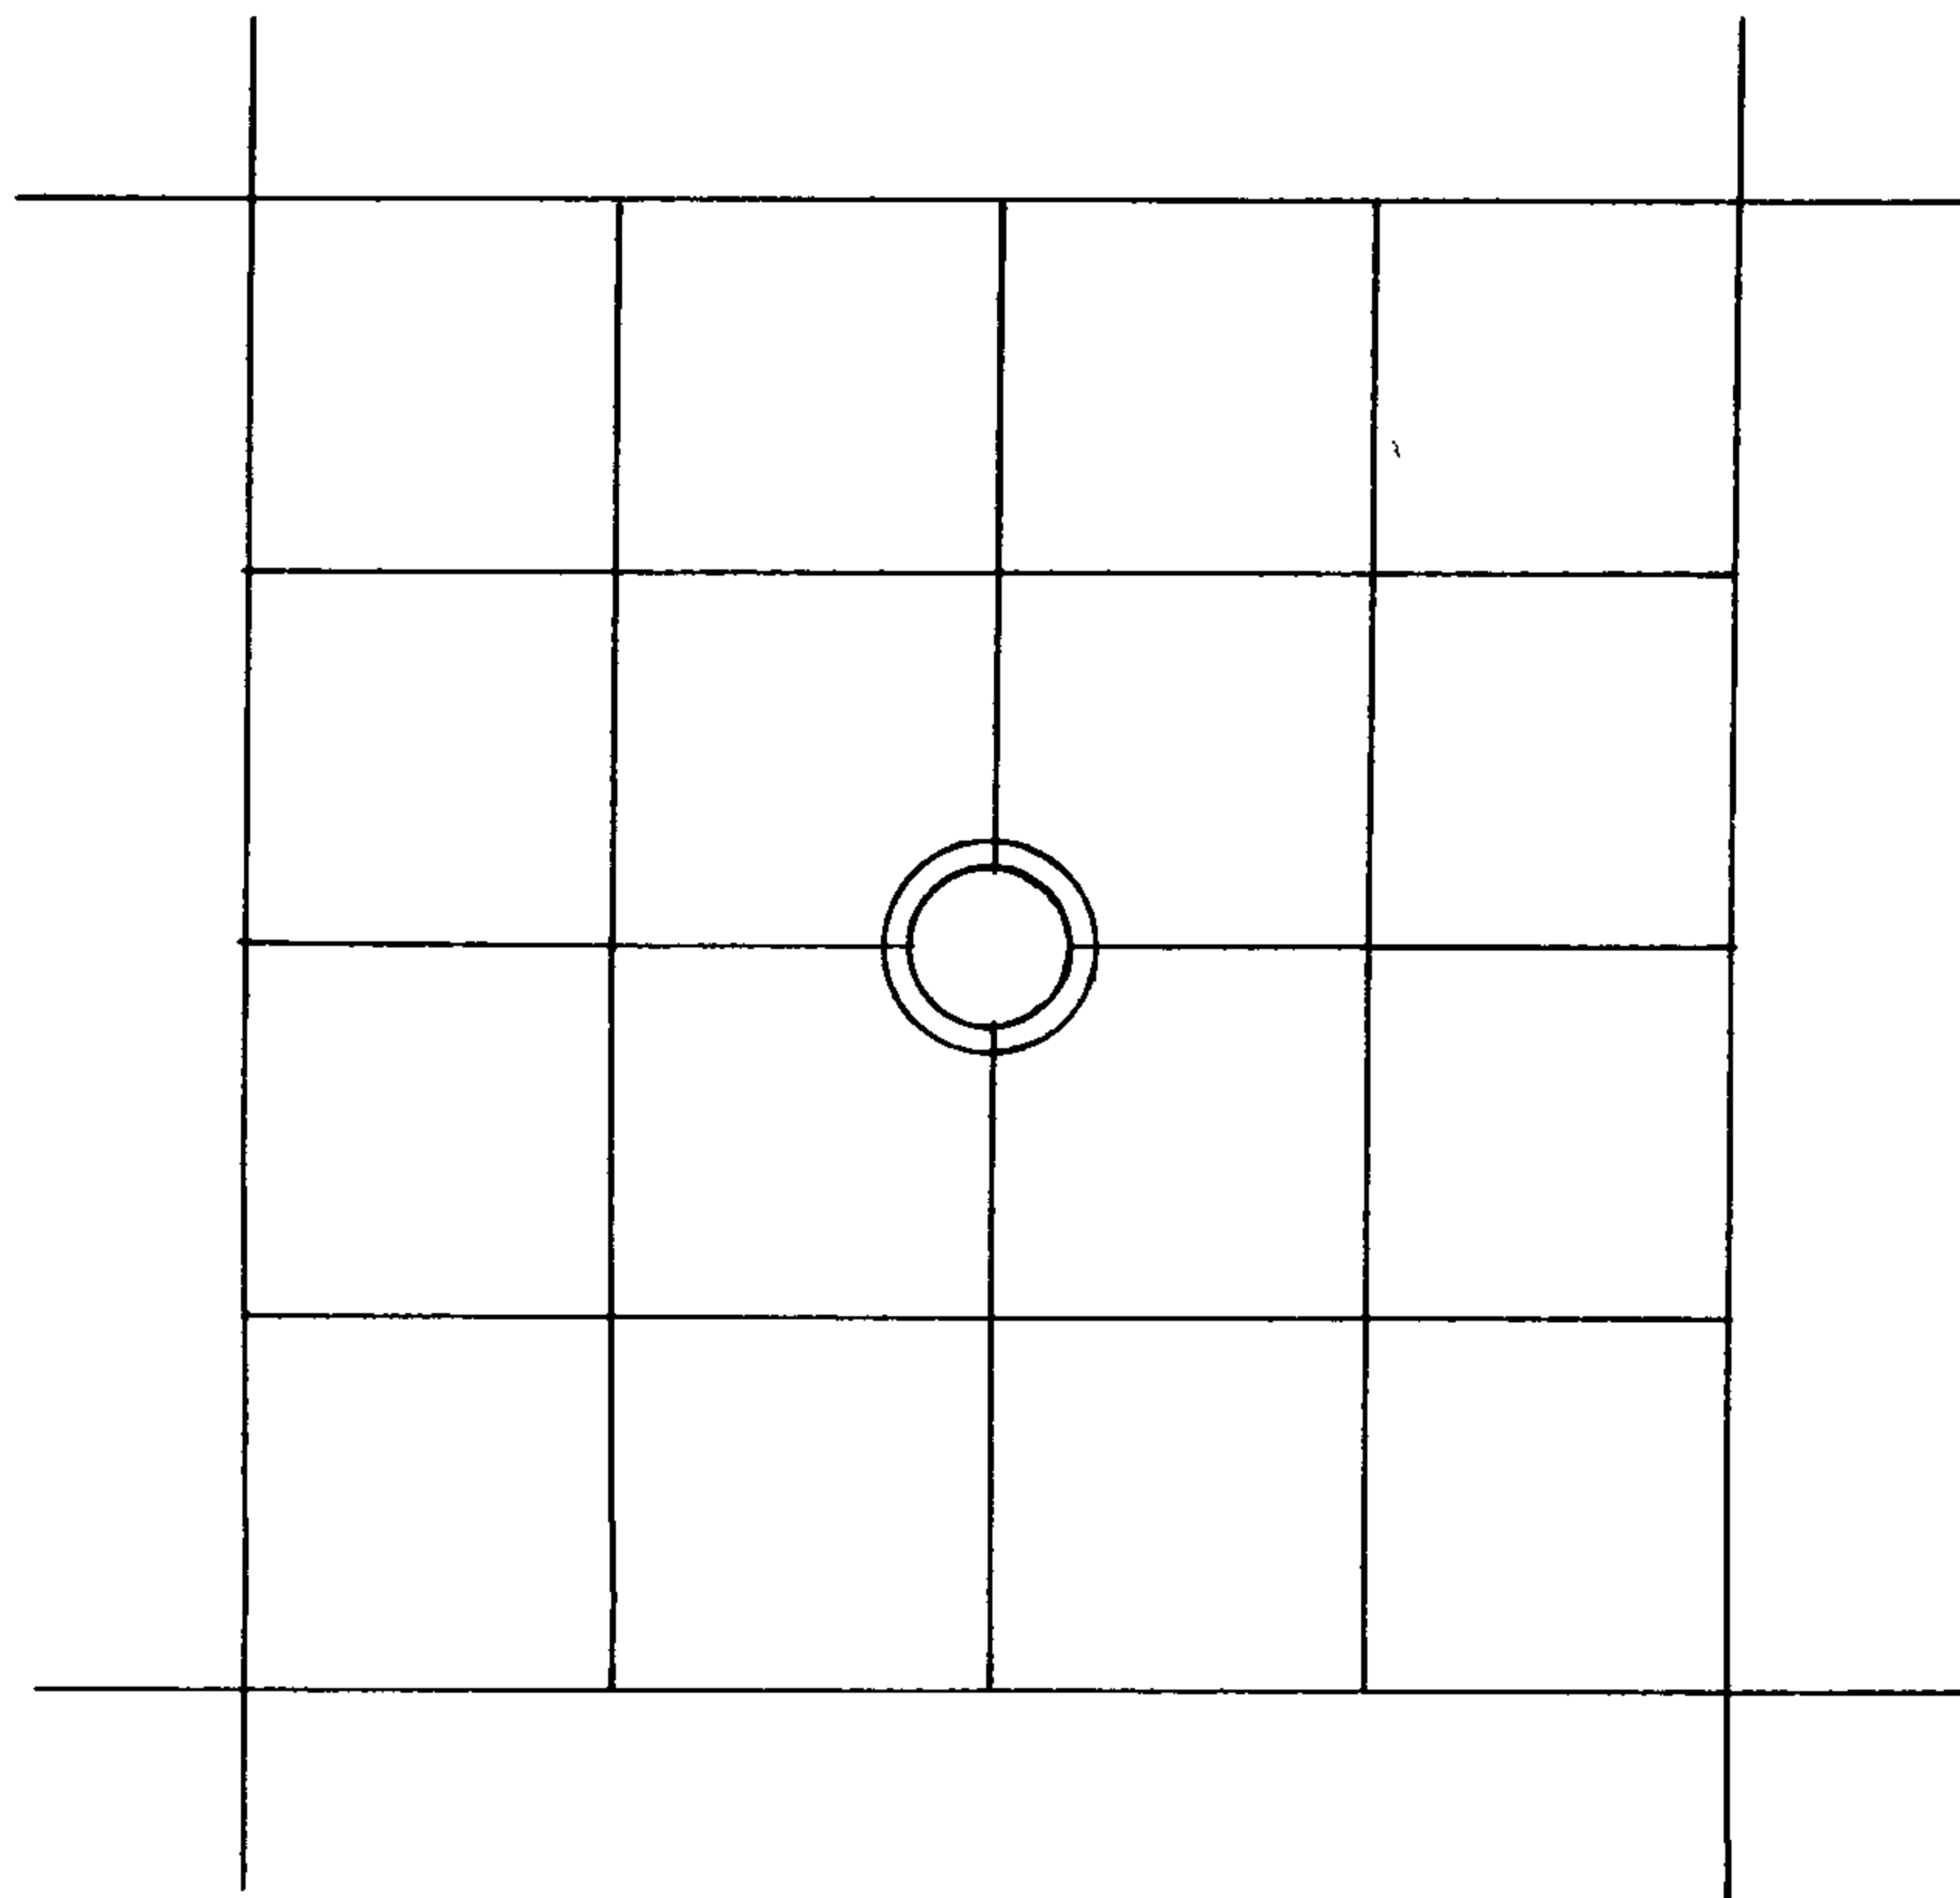

LINE MARKED BY NOTCH CUT IN BLAZE.

○--- KNOWN CORNER.

⊗--- REFERENCED CORNER
BY WEYERHAEUSER
METHOD.

Found in field:

14" Cedar S06°E 31.1 scribing visible. Dated 2/66

ACCESSORIES ADDED THIS DATE:

MAGNETIC DECLINATION 20°E

| | BEARING | FEET | ORIG. B.T. | "W" NAIL | PLATE | BRASS DISC |
|-------------------------------|---------|------|------------|----------|-------|------------|
| No reference added this date. | | | | | | |
| | | | | | | |
| | | | | | | |
| | | | | | | |

IDENTIFIED ON PHOTO:

INFORMATION ON LOCATION OF CORNER AS NOW SET:

GROUND COVER: Logged to NE, F&B to NW, old growth Fir, Hemlock & Cedar to SW and SE

(USING FORM LINES SKETCH TOPOG AT CORNER ON PAGE 2 PLAT)

SLOPE FACES (GIVE BEARING IN DEGREES) W ON MINUS (-) -20 %

NORTH: +10%

SOUTH: -10%

EAST: +10%

WEST: -20% 20' to creek, then ascend

FROM CORNER |

WORK DONE FOR W. CO. _____

FIELD NOTES IN BOOK: _____

BY: Kenneth Perkins DATE: March 1, 1972

~~XXXXXXXXXXXXXXXXXXXX~~
Engineering Aide III

ASSISTED BY: _____

UNDER THE SUPERVISION OF:

COPIES SENT TO: _____

SEAL

C. S. File No. 59/24

PAGE 3

| | | | | | | | |
|----|----|----|----|----|----|----|----|
| 36 | 31 | 32 | 33 | 34 | 35 | 36 | 31 |
| 1 | 6 | 5 | 4 | 3 | 2 | 1 | 6 |
| 12 | 7 | 8 | 9 | 10 | 11 | 12 | 7 |
| 13 | 18 | 17 | 16 | 15 | 14 | 13 | 18 |
| 24 | 19 | 20 | 21 | 22 | 23 | 24 | 19 |
| 25 | 30 | 29 | 28 | 27 | 26 | 25 | 30 |
| 36 | 31 | 32 | 33 | 34 | 35 | 36 | 31 |
| 1 | 6 | 5 | 4 | 3 | 2 | 1 | 6 |

WEYERHAEUSER COMPANY

CORNER REFERENCE METHOD CONSISTS OF:

A "W" NAIL DRIVEN THRU THE HOLE IN A BRASS DISC, INTO A NOTCH CUT LOW ON A TREE, STAMPED WITH THE OREGON REGISTERED LAND SURVEYOR OR PROFESSIONAL ENGINEER REGISTRATION NUMBER.

AN EMBOSSED ALUMINUM PLATE, NAILED HEAD HIGH ON SAME TREE WITH 8D ALUMINUM NAILS, WITH DISTANCE AND BEARING FROM THE "W" NAIL TO THE CORNER STAMPED ON IT.

