

9/8/76

T 305

R3W

R2W

S36

1/4

(1)

FOUND:

A 7" MAPLE THAT BEARS $N 60^{\circ} 1/4 W$;
 14.5'. TREE IS DEAD AND SHOWS
 OLD OPENED FACE. ROTTED AND
 NO VISIBLE SCRIBING.

A 6" NOW 8" LAUREL STUMP THAT
 BEARS $N 28^{\circ} 1/2 E$; 15.8'. NO VISIBLE
 SCRIBING.

THE INTERSECTING POINT FROM
 ABOVE BEARING TREES PLACES
 CORNER POINT APPROXIMATELY
 .10 CHAINS NORTH OF AN EAST
 WEST RAINE AS PER ORIGINAL
 LINE NOTES. ALSO FOUND
 ORIGINAL FIR LINE TREE
 APPROXIMATELY 9.40 CHAINS
 NORTH OF CORNER POINT.


#209 T 30-3 ✓

#200 T 30-2 ✓

C.S. File No.

59/24 ✓

9/8/76

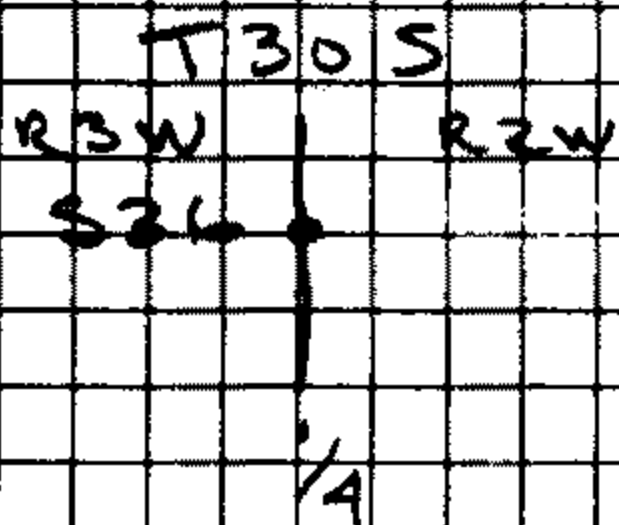

(2)

AT THE CORNER POINT:

WE FIND A WINDMILL APPROXIMATELY
 40" IN DIAMETER MAKING IT
 IMPOSSIBLE TO OCCUPY. WE
 THEREFORE SET A WITNESS
 CORNER STAMPED

DOUGLAS CO. SURVEYOR

WITNESS CORNER

T30 S



SOUTH

47.3'

1976

THE WITNESS CORNER BEARS

DUE NORTH, 47.3' FROM 1/4 CORNER

ITS A 1" X 30" IRON PIPE WITH
 BRASS CAP.

DIETZEN NO. 385-B

G. S. File No. 59/249

9/8/76

T305
WITNESS CORNER

(2)

R3W | R2W
S36

1976

NEW TREES:

A 7' WHITE FIR BEARS S 84 1/2 W; 9.8'
MARKED "WC 1/4 S 36 CS BT" IN A
DOUBLE BLAZE.

AN 8" D. FIR BEARS S 90 1/2 E; 11.9'
MARKED "WC 1/4 R P CS BT" IN A
DOUBLE BLAZE.

COMPASS DECL. 20° E

A. J. [Signature]
PETE EARLE

OK [Signature]

DIETZEN NO. 385-6

C. S. File No. 59/24-9