

RENEWAL

9-13-76

	T 25 5	
R	S 13	R
	—	S 18
W	S 24	E

SEE RENEWAL # 22

(M 19-76 C.S. FILES)

FOUND

1. 48 INCH (REC. 60) FIR, NOW A STUMP
 BEARS N 74° W, 29° FEET. STUMP
 HAS BLAZE, I OPEN END FIND
 SCRIBING "T 25 S R 1 W S 13 BT".

2. STONE 16 X 14 X 7 INCHES (RECORD
 6 X 10 X 8 ABOVE GROUND, ORIGINAL
 12 X 10 X 8) FOUND 3 NOTCHES ON
 OPPOSITE FACES AND S 13 ON
 ANOTHER FACE. ROCK HAS BEEN
 DISLODGED BY WINDFALL BEARING
 TREE

3. A FIR 38 INCH (REC. 36 INCH)
 DIAMETER IS NOW A WINDFALL.
 TREE HAS WELL HEALED BLAZE.

#128 T25-14 ✓

#32 T25-15 ✓

C.S. File No. 59/24C

10

DIETZGEN NO. 385-6

FOUND


4. STEEL TUBE WITH SURVEY CAP,
DISLODGED BY UPROOTED BEARING
TREE. (SEE REN. #22)

RENEWAL

1. SET BRASS CAP AT SECTION CORNER
STAMPED;

"
COUNTY SURVEYORS OFFICE"

T 25 S

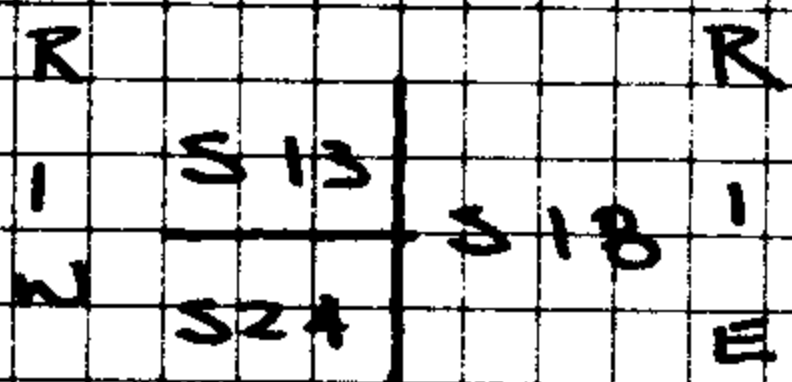

1976

SET CORNER STONE ON NORTH
SIDE OF CAP, SET STEEL TUBE
ON SOUTH SIDE OF CAP.

2. SET 5/8 INCH BY 30 INCH IRON
ROD WITH ALUMINIUM CAP IN
BEARING TREE STUMP, IRON ROD
END CAP BEAR N 25° W,
28.7 FEET. CAP STAMPED "B.O.S."

G.S. FILE NO. 59/24 10

DIETZGEN NO. 385-6

RENEWAL

3. SET SPIKE IN 40 INCH DIAMETER
FIR STUMP, SPIKE BEARS S 50° W,
33 1/2 FEET, SPIKE STAMPED
"B.O. 2".

4. SET CEDER POST 2 INCHES
SQUARE BY 9 FEET. SET POST
2 1/2 FEET INTO THE GROUND, POST
BEARS NORTH, 4 1/2 FEET.

MAG. DEC, 20° E 9-13-76

L. E. MOURREAN

P. L. EARLE

DIETZEN NO. 385-6