

9-16-76

1/4 S 12

T30S R1W

REN. # 92-30-1A

REN # 13 T30-1E

NOTE

THIS CORNER IS LOCATED ALONG THE WILLAMETTE MERIDIAN AS SURVEYED IN 1857 AND LATER CHANGED.

FOUND:

✓ A STONE, 24" X 8" X 6", FIRMLY SET, EXTENDING

B" ABOVE GROUND AND LEAVING WESTERLY,

WITH FAINT "1/4" CHISELED ON WEST FACE

FROM WHICH:

AN ORIGINAL BEARING TREE (1857 SURVEY)

A 15" NOW 34" D. FIR, ALIVE WITH WELL-

HEALED BLAZE BEARS N 10° W 6 1/2 FT.

(REC. N 10° W ~~6~~ 5 1/2 FT.)

AN ORIGINAL BEARING TREE (1857 SURVEY)

A 9" NOW 14" I. CEDAR, ALIVE WITH "BT"

VISIBLE AND UNHEALED BLAZE BEARS

S 40° E 7 1/2 FT. (REC. S 40° E 6 1/2)

NOTE: THE MARKINGS ON THIS TREE WERE

PARTIALLY OBLITERATED DURING THE

1923 RETRACEMENT SURVEY.

G.S. File No. 59/2 PAGE 1

DIETZEN NO. 385-6

964

10958

10958

#150
#24 T30-1E

-B C

AND A BEARING TREE MARKED IN 1923,

A 12" NOW A 20" I. CEDAR BEARS

S 35° W 8⁰ FT., (REC. S 35° W

9⁰ FT., ALIVE AND WELL-HEALED.

NOTE: THE ORIGINAL MEASUREMENT FITS

THIS BT AT BREAST HEIGHT, NOT AT

GROUND LEVEL.

AT THE CORNER POINT, WE SET A 1" X 30"

I. PIPE ~~IN~~, 24" IN THE GROUND, WITH THE

ORIG. STONE ALONG THE WEST SIDE,

STAMPED:

DOUGLAS COUNTY SURVEYOR


T30S R1W

1/4 S 12

1976

COMPASS DECLINATION: 20° EAST

DIP # 92
R1W 1968
1110 (?)
OK

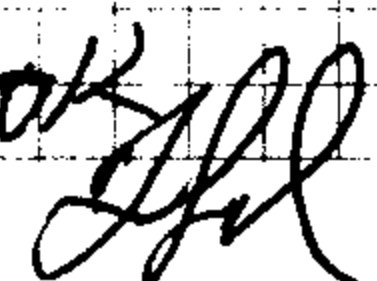

9-16-76
Gary L. Knight
MIKE TOMPKINS

C. S. File No. 59/22-13

DIETZEN NO. 385-6