


9-21-76

T 285

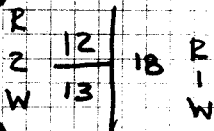

FOUND:

THE ORIGINAL 1923 SW BEARING TREE, AN ORIG. 60" NOW 54" D. FIR ALIVE AND WELL HEALED.

THE 1923 CORNER MONUMENT AND NW BEARING TREE HAVE BEEN LOST DUE TO LOGGING ACTIVITY.

AT THE TRUE CORNER LOCATION AS DETERMINED BY THE RECORD MEASUREMENTS FROM THE ORIGINAL SW BEARING TREE,

WE SET:


A 1" x 30" IRON PIPE, 28" IN THE GROUND WITH BRASS CAP ATTACHED,

#85 T28-2 ✓
#33 T28-1 ✓

STAMPED:

DOUGLAS CO. SURVEYOR

T 28 S

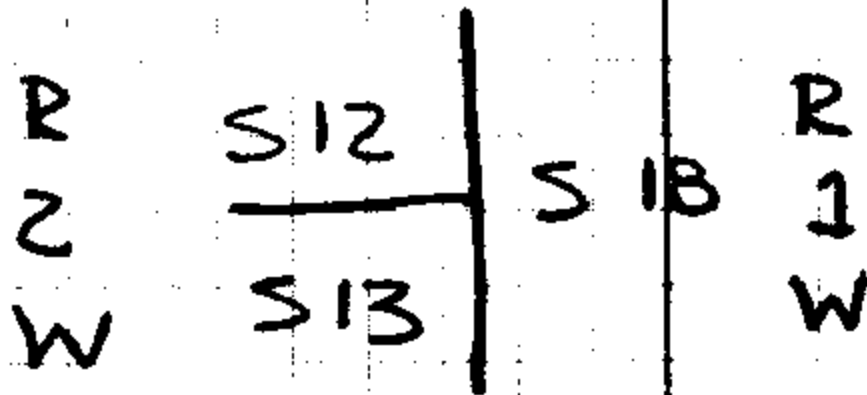

1976

FROM WHICH:

THE ORIGINAL ^{SW} ~~HW~~ BEARING TREE
 BEARS S 34° W 34³/₄ FT.

WE MARK A NEW BT AS FOLLOWS:

A 16" G. FIR BEARS N 10° E 34³/₄ FT.,
 SCRIBED "T28S R1W S18 CS BT"
 ON A DOUBLE BLAZE.

COMPASS DECLINATION: 20° EAST

9-21-76

Gary Langlit

KAREN CHENEY

C. S. File No. 59/28

O/S [Signature]

-15