

9/27/76

TBOS RIW

SEE PLAN # 3

S15 | S14

①

1/4

FOUND:

A 14" X 11" X 6" STONE (REC. 12" X 8" X 6")

FROM WHICH:

A 42" PINE STUMP BEARS S83°E;  
107.5' SHOWS FRAGMENTARY SCRIBING  
A PRONOUNCED "BT"

A DOWN 30" CEDAR BEARS N89 1/2°W;  
149.2' SHOWS "1/4 S BT" IN A  
DOUBLE BLAZE.

NO SIGN OF ORIGINAL B.T.'S  
OR CORNER POST.

SET: A 1' X 30" I.P. WITH BRASS  
CAP STAMPED:

DOUGLAS CO. SURVEYOR

TBOS RIW

S15 | S14

1/4

1976

1/4

#151 ✓

C.S. File No. 59/24C

DIETZGEN NO. 385-6

9/28/76

T30S RLW

SEE PAGE 3

S 15 S 14

(2)

SET FOUND STONE ON NORTH  
SIDE OF CAP.

NEW TREES

A 6" D. FIR BEARS N36°W; 8.0'  
MARKED "1/4 S 15 C S BT"

A 5" D. FIR BEARS S67°E; 13.9'  
MARKED "1/4 S 1 A C S BT"

COMPASS DEC 20°E

A. Vinton Cannon  
Mike L. Tompkins

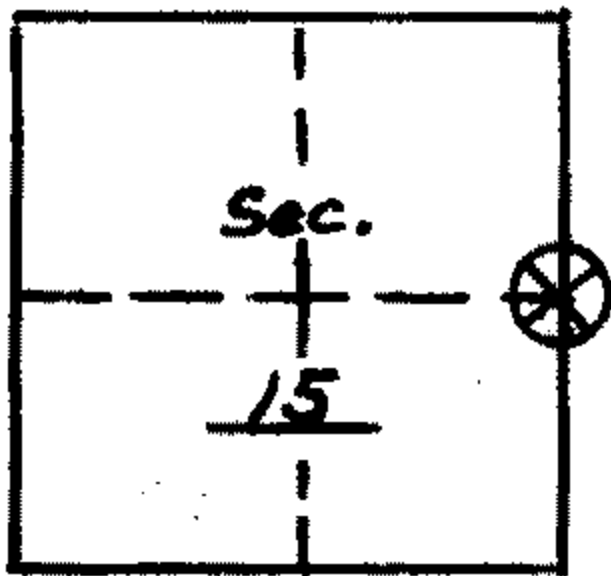
OK  
*[Signature]*

C. S. File No. 59/24

DIETZGEN NO. 385-6

## PROPERTY CORNER INVESTIGATION

LOCATION

T. 30S R. 1WMer. WILL State OREForest UMPO Dist. TILLER

## LEGEND

- Corner searched—no evidence
- ⊗ Corner or accessory found
- Corner marked by perm. mon.

## DESCRIPTION OF FOUND CORNER

MATERIAL: STONE SIZE: 12" x 8" x 6"HEIGHT ABOVE GROUND: 4" CONDITION: FAIRMARKINGS: NONE

## DESCRIPTION OF FOUND ACCESSORIES

A WELL ROTTED PINE STUMP BEARS  $S83^{\circ}E, 107.58'$   
SCRIBING VISIBLE, "1/4 S" "BT".

A 30" CEDAR IS DOWN & OUT OF PLACE (MOVED BY  
LOGGING ACTIVITIES) DID BEAR  $N89^{\circ}35'W, 149.16'$ .  
SCRIBING VISIBLE, "1/4 S" "BT"

OLD EAST-WEST FENCE LINE LIES 200' NORTH.  
SMALL STREAM LIES 130' WEST.

NOTE: Indicate full investigative details on back of form.

## PHOTO IDENTIFICATION

Symbol & date \_\_\_\_\_ Line or  
Roll \_\_\_\_\_ Exposure \_\_\_\_\_

How Identified \_\_\_\_\_ Where filed \_\_\_\_\_

RECOVERED BY: D. GAYLORDDATE: AUG 9, 1976TITLE: CIVIL ENGR TECH