

9/27/76

T30S R1W



FOUND:

AN ORIGINAL 40" NOW 48" PINE STUMP WITH PREVIOUSLY OPENED DOUBLE BLAZES. FIND FRAGMENTARY SCRIBING ON TOP BLAZE AND "BT" SHOWING ON BOTTOM. BLAZE DOES NOT FACE CORNER.

AN 18" OAK PREVIOUSLY OPENED. COULD FIND NO SIGN OF SCRIBING.

NO EVIDENCE OF ORIG. CORNER POST.

GIVEN THE BEARINGS AND DISTANCES FROM ABOVE PINE STUMP AND 18" OAK AN INTERSECTING POINT IS IMPOSSIBLE. IF DISCOUNT THE OAK AS A BEARING TREE AND SET CORNER OFF OF ORIG. PINE STUMP. IT BEARS S14°E; 21.8'

DIETZGEN NO. 3885-6

#152 ✓

G. S. FILE NO. 59/24 C

120

9/27/76

T 30S R1W

S11
S1A

SET:

A 1" x 30" I.P. WITH BRASS CAP

STAMPED DOUGLAS CO. SURVEYOR

T 30S R1W

S11
S1A

1976

NEW TREES:

A 36" B. OAK BEARS S 3° W; 46.2'

MARKED "1/4 S 1A CS BT."

A 14" D. FIR BEARS N 32° E; 11.2'

MARKED "1/4 S 11 CS BT."

Compass DEC. 20° E

A. Victor Camp

MIKE L. Tompkins

OK
[Signature]

C.S. File No. 59/24

DIETZEN NO. 385-B

RECOVERY NOTES


PROPERTY CORNER INVESTIGATION

LOCATION

T. 30S R. 1W

Mer. WILL State ORE

Forest UMPO Dist. TILLER

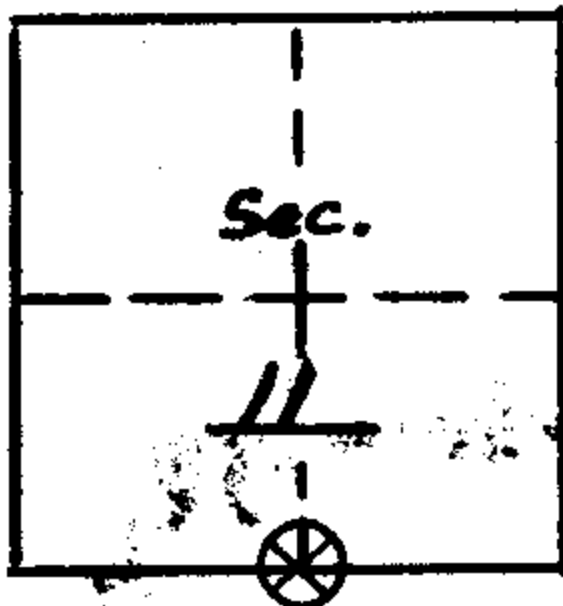

LEGEND

- Corner searched—no evidence
- Corner or accessory found
- Corner marked by perm. pon.

DESCRIPTION OF FOUND CORNER

MATERIAL: NONE SIZE: _____

HEIGHT ABOVE GROUND: _____ CONDITION: _____

~~ENTRANCE:~~ AN UNMARKED STONE IS PARTIALLY BURIED AT APPROX. CORNER.

DESCRIPTION OF FOUND ACCESSORIES

18" (ORIG 12") OAK HAS HEALED LOWER SCARF
 ROTTED UPPER BLAZE, BEARS N89°E, 19.8'
 48" (ORIG 40") PONDEROSA PINE STUMP HAS DOUBLE
 BLAZE, OPEN AND FIND FAINT SCRIBING
 ON BOTH. BEARS S74°E (NOT 14°) 21.70'
 FOUR STRAND BARBED WIRE FENCE IS 70' W (Runs N-S)

NOTE: Indicate full investigative details on back of form.

PHOTO IDENTIFICATION

Symbol & date _____ Line or Roll _____ Exposure _____
 How Identified _____ Where filed _____ *Forest Service*

RECOVERED BY: D. GAYLORD

DATE: 7/28/76

TITLE: CIVIL ENGINEER