

T295

9-28-76

S 32

R

T 305

E

1/4 sec

FOUND:

ORIG CORNER TREE (CALL 20" FIR) WHICH IS NOW A 24" ROTTEN STUMP 6" ABOVE GROUND.

FROM WHICH:

AN ORIG 20" NOW 30" FIR BEARS: N33°W 2 1/2 FT. TREE IS ALIVE WITH WELL HEALED BLAZE.

AN ORIG. 15" NOW 30" FIR BEARS: S 28° E 20 FT. TREE IS ALIVE WITH WELL HEALED BLAZE.

SET AT TRUE CORNER POINT:

A 1" X 36" I. PIPE WITH BRASS CAP. STAMPED

" DOUGLAS CO. SURVEYOR

T 295

1/4 S 32 R

T 305

1976"

\*NOTE: I. PIPE WAS POUNDED INTO HEART OF ORIG CORNER TREE.

9-28-76

COMPASS DEC. 20° EAST

M. LENO RAJAB  
KAREN CHENEY

#132

~~132~~ - T29-15 ✓

#31-13-15 U.S. File No. 59/24

OK *[Signature]*

- 21

C

DIETZGEN NO. 3885-6

RECOVERY NOTES


PROPERTY CORNER INVESTIGATION

LOCATION

T. 295 R. 1E

Mer. WILL. State ORE.

Forest UMPQ. Dist. TILLER

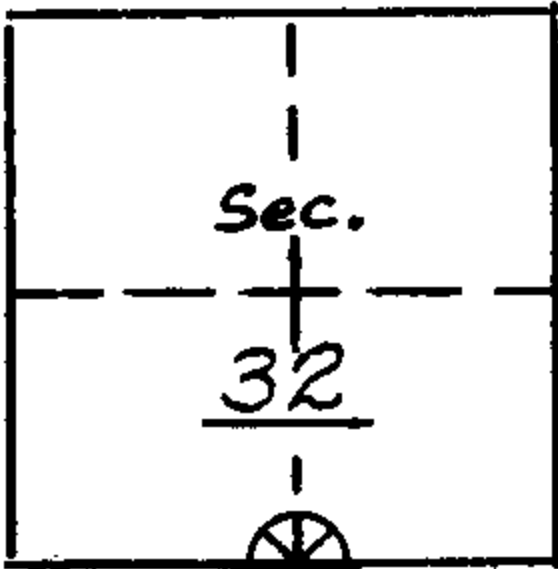

LEGEND

- Corner searched-no evidence
- Corner or accessory found
- Corner marked by perm. mon.

DESCRIPTION OF FOUND CORNER

MATERIAL: STUMP SIZE: 24"

HEIGHT ABOVE GROUND: 12" CONDITION: ROTTED

MARKINGS: NONE VISIBLE

DESCRIPTION OF FOUND ACCESSORIES

24" (ORIG 20") FIR BEARS N33°W, 2.64'  
HAS A HEALED BLAZE.

15" FIR BEARS S28°E, 28.38'  
HAS A HEALED BLAZE.

N.E. BEARING TREE IS GONE.

PLACED B.T. TAGS ON BOTH TREES.

NOTE: Indicate full investigative details on back of form.

CORNER IS 150' PHOTO IDENTIFICATION S. OF F.S.  
ROAD # 298

Symbol & date \_\_\_\_\_ Line or Roll \_\_\_\_\_ Exposure \_\_\_\_\_

How Identified \_\_\_\_\_ Where filed \_\_\_\_\_

RECOVERED BY: D. GAYLORD

DATE: 9-8-76

TITLE: CIVIL ENGR. TECH.