

T29S R1E

S31 | S32

①

T30S R1E

FOUND:

A 12" x 10" x 7" (REC. 15" x 10" x 8") WITH FIVE NOTCHES ON E. FACE AND ONE NOTCH ON WEST FACE AS PER RECORD.

I FIND NO TRACE OF "S32" ON NE FACE OR "S31" ON NW. FACE. I ALSO FIND "GS." ON S. FACE AND "X" CHISELED ON TOP BOTH NOT OF RECORD. THE STONE WAS DISTURBED AND I

RE-ESTABLISH PROPER LOCATION FROM A 7' NOW 11' CEDAR THAT BEARS S50W (REC. S48W), 29.0'. I OPEN FIND OLD FACE WITH ALL BUT FRAGMENTARY SCRIBE LINES OBLITERATED AS PER RECORD. (WHEN RE-SURVEY DETERMINED THAT ABOVE CORNER IS NOT COMMON TO FOUR SECTIONS, BUT TO TWO.)

#29 T30-1E ✓
#127 T29-1E ✓

T29S R1E

S31 | S32

(2)

T30S R1E

AN ORIGINAL 20" NOW 36" FIR BEARS
S35°E; 29.9' ALIVE AND WELL. ALSO
SHOWS GOOD SCAR.

I FIND NO SIGN OF ANY OTHER
BEARING TREES.

SET:

A 1" x 30" I.P. WITH BRASS CAP
STAMPED: DOUGLAS CO. SURVEYOR

T29S R1E

S31 | S32

T30S R1E

1976

NEW TREES:

A 6" W. FIR BEARS N58°W; 20.7'
MARKED "T29S R1E S31 CS BT" IN A
DOUBLE BLAZE.

T 295 RIE



(3)

T 305 RIE

NEW TREES:

A J. W. FIR BEARS NS $1\frac{1}{2}^{\circ}$ E; 650'

MARKED "T 295 RIE S 32 CS BT" IN

A DOUBLE BLAZE.

DIETZEN NO. 385-6

COMPASS DEC. 20'E.

A. V. [Signature]

PETE EARLE

MIKE TOMPKINS

OK [Signature]


PROPERTY CORNER INVESTIGATION

LOCATION

T. 29S R. 1E

Mer. WILL State OR

Forest UMP. Dist. TILLER

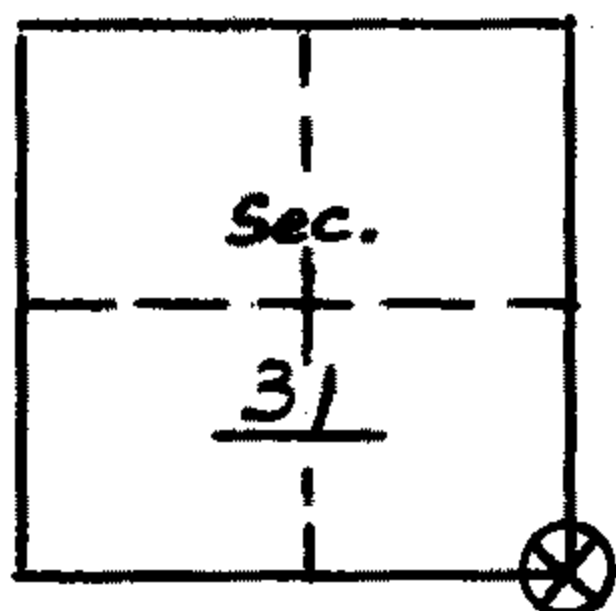

LEGEND

- Corner searched-no evidence
- ⊗ Corner or accessory found
- Corner marked by perm. mon.

DESCRIPTION OF FOUND CORNER

MATERIAL: STONE SIZE: 15" x 10" x 8"

HEIGHT ABOVE GROUND: — CONDITION: OUT OF PLACE

MARKINGS: "G 5" ON ONE FACE, 5 GROOVES ON ONE FACE AND "X" ON TOP.

DESCRIPTION OF FOUND ACCESSORIES

36" (ORIG 24") FIR BEARS S 35° E, 24.42', HAS HEALED SCAR,
 10" (ORIG 7") CEDAR BEARS S 48° W, 29.04', HAS HEALED SCAR.
 MADRONE STUMP BEARS N 33° W, 12.54'.
 CORNER STONE IS AT BASE OF STUMP.
 N, E, B, T, IS GONE

NOTE: Indicate full investigative details on back of form.

PHOTO IDENTIFICATION

Symbol & date _____ Line or Roll _____ Exposure _____

How Identified _____ Where filed _____

DATE: 7/15/76

RECOVERED BY: D. GAYLORD

TITLE: CIVIL ENGR TECH