

1011176

T295 RIE

$\frac{1}{4}$ ———

SS

①

T305 RIE

FOUND:

A 20" x 10" x 6" STONE, LOOSE, AND MARKED " $\frac{1}{4}$ SS" ON SOUTH FACE.

FROM WHICH:

A 10" (RECORDED 12" WHEN SCRIBED)

D. FIR BEARS S44°E (RECORD S38°E);

38.9' I OPEN AND FIND " $\frac{1}{4}$ SS BT"

AS PER RECORD.

A 30" D. FIR BEARS S12°W; 17.8'

SHOWS GOOD SCAR AND IS HEALTHY.

SET:

A 1" x 30" I.P. WITH BRASS CAP

STAMPED: DOUGLAS G. SURVEYOR

T295 RIE

$\frac{1}{4}$ ———

SS

T305 RIE

#27 T30-1E ✓
#129 T29-1E ✓

1976
C.S. FILE NO. 59/2A-20 C

10/11/76

T 29 S R 1 E



S 5

T 30 S R 1 E

1976

(2)

I REPLACEMENT FOUND STONE ON SOUTH
SIDE OF CAP WITH MARKS FACING SOUTH.

COMPASS DEC. 20° E

A. Venter Cange

NOTE:

CORNER LIES APPROX. 200' SOUTH
OF F.S. ROAD # 298


OK
JHL

C. S. File No. 59/24-28

RECOVERY NOTES

PROPERTY CORNER INVESTIGATION

LOCATION

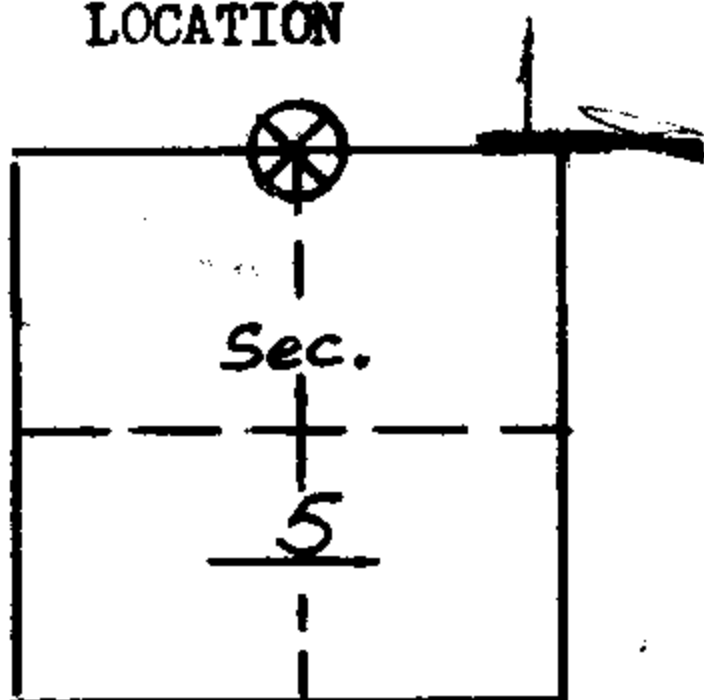

T. 30S R. 1E

Mer. WILL. State ORE.

Forest UMPO Dist. TILLER

LEGEND

- Corner searched-no evidence
- Corner or accessory found
- Corner marked by perm. mon.

DESCRIPTION OF FOUND CORNER

MATERIAL: STONE SIZE: 20" x 10" x 6"
 HEIGHT ABOVE GROUND: 10" CONDITION: FAIR (LOOSE)
 MARKINGS: "1/4 SS" ON SOUTH FACE

DESCRIPTION OF FOUND ACCESSORIES

12" FIR BEARS S38°E, 38.94' HAS A HEALED BLAZE.
 30" FIR BEARS S12°W, 17.82' HAS A HEALED BLAZE.
 PLACED B, T, TAGS ON BOTH TREES
 CORNER LIES 150' SOUTH OF F.S.
 ROAD #298.

NOTE: Indicate full investigative details on back of form.

PHOTO IDENTIFICATION

Symbol & date _____ Line or Roll _____ Exposure _____
 How Identified _____ Where filed _____

RECOVERED BY: D. GAYLORD

DATE: 9-8-76

TITLE: CIVIL ENGR. TECH.