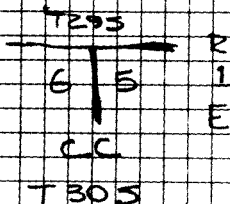


10-11-76

FOUND:

A CONGLOMERATE STONE, FIRMLY SET,
 18" X 14" X 7" (RECORDED 20" X 16" X 7")
 EXTENDING 10" ABOVE GROUND AND SUPPORTED
 IN A MOUND OF STONE, WITH 5 GROOVES
 AND A "5" AND OTHER ILLEGIBLE CHISEL
 MARKS ON THE EAST FACE, 1 GROOVE
 AND A "6" AND OTHER ILLEGIBLE CHISEL
 MARKS ON THE WEST FACE. WE DO
 NOT FIND ANY MARKS ON THE SOUTH
 FACE.

FROM WHICH:

THE TWO ORIGINAL BEARING TREES
 ARE LOCATED AS FOLLOWS:

AN ORIG. 16" NOW 20" D. FIR BEARS
 S 18° E 21^B FT., ALIVE AND WELL

26
 T30-1E ✓ HEALD,

#130 T29-1E ✓

C. S. File No.

59/24-29

PAGE 1 C

AND AN ORIGINAL 4" NOW 17" GRAND
 FIR BEARS S 11° W 17 $\frac{1}{2}$ FT., (RECORD
 S 18° W 17 $\frac{1}{2}$ FT.), ALIVE AND WELL-
 HEALED

AT THE TRUE LOCATION FOR THE CLOSING
 CORNER, WE SET A 1" X 30' IRON PIPE,
 26" IN THE GROUND AND SUPPORTED IN A
 MOUND OF STONE, WITH BRASS CAP
 ATTACHED, STAMPED:

DOUGLAS CO. SURVEYOR

T 29 S

R
1
E

SE | SW

CC

T 30 S

1976

WE PLACE THE ORIGINAL STONE ALONG
 THE SOUTH SIDE OF THE BRASS CAP,
 AND MARK THE FOLLOWING NEW
 BEARING TREE:

A 12" HEMLOCK BEARS 380° W
182 FT., SCRIBED "CC SE T30S RIE CS BT"
ON A ~~A~~ DOUBLE BLAZE.

COMPASS DECLINATION SETTING: 20° EAST

10-11-76

Jay L. Langley

KAREN CHENEY

ok
JL

DIETZGEN NO. 385-6

RECOVERY NOTES


PROPERTY CORNER INVESTIGATION

LOCATION

T. 30S R. 1E

Mer. WILL State OR

Forest UMP. Dist. TILLER

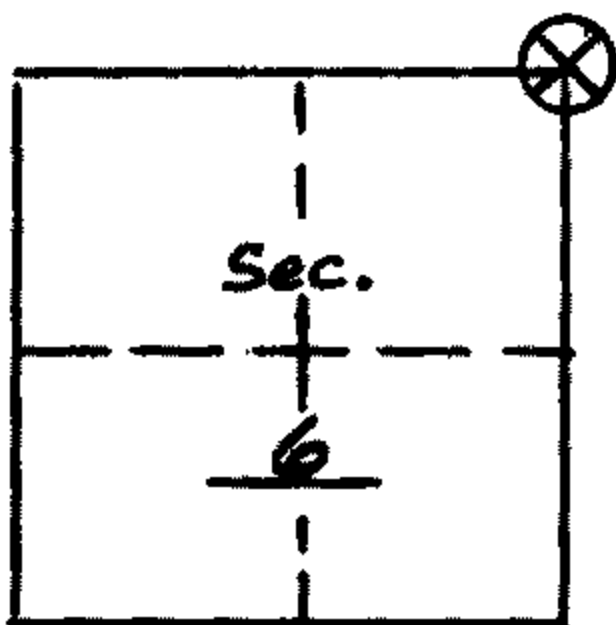

LEGEND

- Corner searched—no evidence
- ⊗ Corner or accessory found
- Corner marked by perm. mon.

DESCRIPTION OF FOUND CORNER

MATERIAL: STONE SIZE: 20" x 16" x 7"

HEIGHT ABOVE GROUND: 8" CONDITION: GOOD

MARKINGS: "E, G 5" PLUS 5 GROOVES ON EAST FACE, IN 3' MOUND OF ROCKS

DESCRIPTION OF FOUND ACCESSORIES

14" FIR BEARS S18°W (S10°W?), 17.82' WITH HEALED SCAR

16" FIR BEARS S18°E, 21.78' WITH HEALED SCAR.

CORNER LIES 200' NORTH OF F.S. ROAD #298 AND 55' EAST OF SEC COR 31132

NOTE: Indicate full investigative details on back of form.

PHOTO IDENTIFICATION

Symbol & date _____ Line or Roll _____ Exposure _____

How Identified _____ Where filed _____

RECOVERED BY: D. GAYLORD

DATE: 7/10/76

TITLE: CIVIL ENGR TECH