

10-12-76

T335 RSW SECTION 12

WITNESS CORNER

MINERAL SURVEY #920

COR. 2

"HARD TIMES LODGE"

FOUND:

THE TWO ORIGINAL BEARING TREES AS

FOLLOWS:

AN ORIGINAL 16' D. FIR, NOW A 17" STUMP
BEARS $S 30\frac{1}{2}^{\circ} W 49\frac{1}{2} FT.$, WITH TRACES
OF SCRIBING VISIBLE ALONG THE EDGES
OF AN UNHEALED BLAZE. IT APPEARS AS
IF THE SCRIBING HAS BEEN CHOPPED OUT.

AND AN ORIGINAL 20' FIR, NOW A 24" SNAG
BEARS $S 63^{\circ} W 48\frac{1}{2} FT.$, WITH NO
MARKS VISIBLE ON AN UNHEALED BLAZE.

THE ORIGINAL MONUMENT IS GONE.

AN UNRECORDED $\frac{3}{8}$ " IRON ROD BEARS
 $S 78^{\circ} E 1\frac{3}{4} FT.$

DIETZEN NO. 385-6

$$70^\circ @ 30^\circ, 8660 = 60 \underline{6}$$

13.4

LESS 0.6 =

.866

70

60.620

60°

EAST TO WC

WC BT'S

26" A. Fire

N 75° E

"WC HT 2 920 CS BT"

$$27^\circ @ 23^\circ, 9205 = \boxed{24 \frac{8}{10} \text{ FT}}$$

12" MADRONE

S 21° W 95 FT, LUL.


"WC HT 2 920 CS BT"

$$\begin{array}{r} .9205 \\ 27 \\ \hline 64433 \\ 18410 \\ \hline 248535 \end{array}$$

DUE TO IMPENDING ROAD CONSTRUCTION
IN THE AREA, WE DO NOT MONUMENT
THE TRUE CORNER POINT. WE SET A
WITNESS CORNER AS FOLLOWS:

AT A POINT 60 FT. EAST OF THE TRUE
CORNER POINT, WE SET 1" X 30" IRON PIPE,
28" IN THE GROUND FOR THE WITNESS
CORNER, WITH BRASS CAP ATTACHED,
STAMPED:

DOUGLAS CO. SURVEYOR
T335 RSW
WITNESS COR.

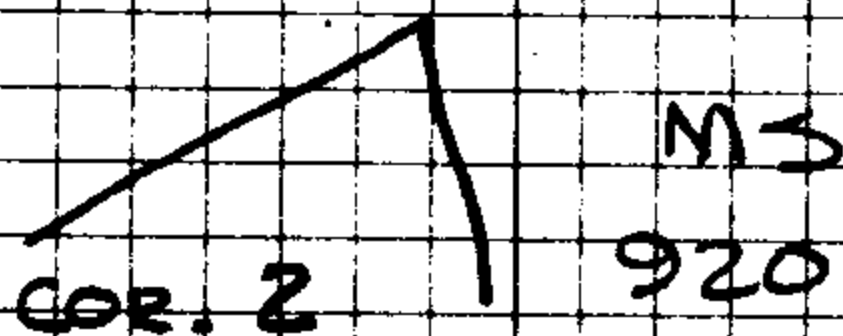

WEST 60 FT. TO
TRUE COR.

1976

WE MARK NEW BEARING TREES FOR
THE WITNESS CORNER AS FOLLOWS:

DIETZEN NO. 385-B

A 26" D. FIR BEARS N 75° E 24⁸ FT.,
 SCRIBED "WC HTZ 920 CS BT" ON
 A DOUBLE BLAZE.

AND A 12" MADRONE BEARS S 21° W 9⁵ FT.,
 SCRIBED "WC HTZ 920 CS BT" ON
 A DOUBLE BLAZE.

COMPASS DECLINATION SETTING: 20° EAST

10-12-76

Larry L. Langley

KAREN CHENEY

OK
 [Signature]