

T 32 S R S W

$\frac{1}{4}$	S 12
	S 13

SEE RENEWALS # 32, 154

FOUND

1. A 50 INCH DOUBLE MAPLE BEARS  
S 73  $\frac{1}{4}$ " W, 194  $\pm$  FEET. TREE  
PARTIALLY OPENED, SCRIBE MARK  
VISIBLE.

FISH TREE IN NW QUADRANT  
HAS BEEN PUSHED OUT BY CAT.

B.T.'S SCRIBED BY POWELL IN  
RENEWAL NO: 154 ARE IN, AS  
THE LEFT BANK OF COW CREEK  
HAS ERRODED CLOSE TO THESE  
TREES, I DO NOT RENEW THE CORNER  
AS WITNESSED BY THESE TREES.  
IRPSS CAP SET BY POWELL NOT  
FOUND.

#197 ✓

U. S. File No. 59/29C

RENEWAL

1. I SET WITNESS CORNER 30<sup>0</sup> FEET  
EAST OF 1/4 CORNER, CAP IS  
STAMPED;

"DOUGLAS COUNTY SURVEYOR"

T 32 S R 5 W

W. C.

WEST 30<sup>0</sup> FEET

TO 1/4  $\frac{S 12}{S 13}$

1976

NOTE: THE CORNER POINT WAS  
ESTABLISHED BY USING A FACE  
MEASUREMENT TO THE 50  
INCH MAPLE. THIS MEASUREMENT  
AGREED CLOSER TO POINT WITNESSED  
BY POWELL'S BEARING TREES.

NEW  
BEARING TREES

2. AN ASH, 15 INCHES DIAMETER  
BEARS N 40 1/2<sup>0</sup> E, 150<sup>+</sup> FEET.  
TREE BLAZED AND SCRIBED

DIETZGEN NO. 3885-6

C. S. File No. 59/24

" W C 1/4 S 12 CS BT "

3. A MAPLE, (SCRIBED BY POWELL  
1967) 14 INCHES DIAMETER BEARS  
N 7° 30' W, 7<sup>0</sup> FEET. (BEARING  
AND DISTANCE RECORDED TO  
CENTER OF BASE ON BOTH B.T.S)

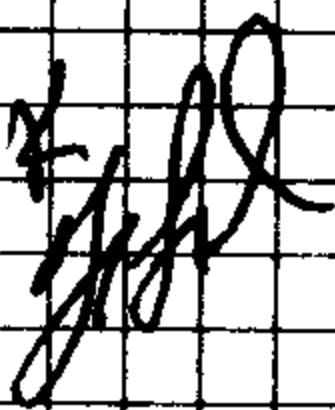
MAGNETIC DECLINATION 20° EAST

10-18-76

L.E. MONREAN

P.L. EARLE

M. TOMPKINS

07  


C. S. File No. 59/24-36