

T 23 S

35	36	RIW
2	1	

T 24 S

FOUND

AN ORIG. 15" FIR, NOW 28",
DOWN WITH ILLEGIBLE SCRIBE
MARKS IN BLAZE OPENED BY
SOMEONE PRIOR TO THIS DATE.

AN ORIG. 14" FIR, NOW 34"
ALIVE WITH WELL HEALED BLAZE

AN ORIG. 13" FIR, NOW 22"
ALIVE WITH WELL HEALED BLAZE

WE FIND NO SIGN OF
COR. POST

AT THE CORNER POINT
FROM WHICH THE ABOVE MENTIONED
TREES BEAR AS FOLLOWS:

#5 T23-1 ✓
#114 T24-1 ✓

OVER

W. S. File No. 59/24

DIETZGEN NO. 385-6

40

AN ORIG. 15" FIR, NOW 28"
(DOWN) BEARS N 58° E 29 1/2 FT.

AN ORIG. 14", NOW 34" FIR
BEARS S 76° E 19 1/2 FT.
(REC. S 81° E 19 1/2 FT.)

AN ORIG. 13" NOW 22" FIR
BEARS N 18° W 17 1/2 FT.

WE SET A 1" x 30" IRON
PIPE WITH BRASS CAP ATTACHED
FLUSH WITH GROUND
MARKED:

DOUGLAS CO. SURVEYOR

T 235		
S 35	S 36	R/W
S 2	S 1	
T 245		

FROM WHICH NEW BT'S
BEAR AS FOLLOWS:

A 7" FIR BEARS N 76° E
14 1/2 FEET SCRIBED "T 235"

(NOTES BEARING TAKEN APPROX 1 1/2 FT
SOUTH OF TREE TRUNK DUE TO
SHAPE OF TREE

C. S. File No. 59/27

R 1 W S 36 CS BT
IN A DOUBLE BLAZE

A 13" FIR BEARS S 9 $\frac{1}{2}$ ° W
20 $\frac{1}{2}$ FT SCRIBED "S 2

T 245 R 1 W CS BT IN
A DOUBLE BLAZE.

COR. LIES ON N.E. SLOPE

MAG. DEC. 20° E

Gregory E. Jule

GARY L. LAUSITZ

KAREN CHENEY

10-21-76

OK
ghl

U. S. File No. 59/24

RECOVERY NOTES


PROPERTY CORNER INVESTIGATION

LOCATION

T. 245 R. 1W

Mer. Will. State ORE.

Forest UMPO Dist. C.G.

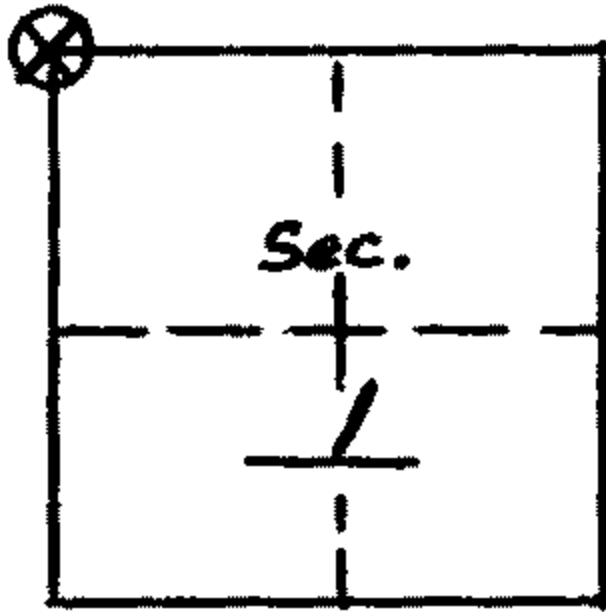

LEGEND

- Corner searched-no evidence
- Corner or accessory found
- Corner marked by perm. mon.

DESCRIPTION OF FOUND CORNER

MATERIAL: NONE SIZE: _____

HEIGHT ABOVE GROUND: _____ CONDITION: _____

MARKINGS: _____

DESCRIPTION OF FOUND ACCESSORIES

40" (ORIG 14") FIR BRS. S 81° E, 19.8'
 24" (ORIG 13") FIR BRS. N 18° W, 17.82'
 36" (ORIG 18") DOWN FIR, CHOP OUT
 & FIND FAINT SCRIBING, STUMP HOLE
 BEARS N 58° E, 29.7'. ALL SHOW HEALED
 SCARS. PLACED B.T. TAGS ON LIVING B.T.'S
 NOTE: Indicate full investigative details on back of form.

PHOTO IDENTIFICATION

Symbol & date _____ Line or Roll _____ Exposure _____

How Identified _____ Where filed _____

RECOVERED BY: D. GAYLORD

DATE: 4/29/76

TITLE: CIVIL ENGR. TECH.