


10-25-76

T225

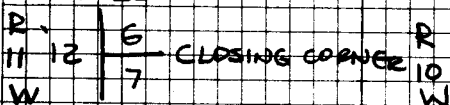

(SEE M 56-56, AUGUST, 1976  
BY BAUGHMAN SURVEYING SERVICE)

FOUND:

A  $\frac{5}{8}$ " IRON ROD SET BY BAUGHMAN IN  
1976 BY SURVEY, FROM WHICH WE FIND  
THE FOLLOWING BEARING TREES MARKED BY  
BAUGHMAN:

A 4" MADRONE BEARS N 6° E 18<sup>5</sup> FT., WITH  
BARK SCRIBING "CC T225 R10W 56 BT"  
VISIBLE

A 10" D. FIR BEARS S 50° E 28<sup>1</sup> FT., WITH  
SCRIBING "CC T225 R10W 57 BT" VISIBLE  
ON AN UNHEALED SINGLE BLAZE.

AND A 24" D. FIR BEARS S 5° W 29<sup>2</sup> FT.,  
(RECORDED PER M 56-56, 20" FIR S 10° W 29<sup>3</sup> FT.)  
WITH SCRIBING "~~CC~~ CC T225 R11W 512 BT"  
VISIBLE ON AN UNHEALED SINGLE BLAZE.

#78 T22-10

#147 T22-11

DIETZEN NO. 385-6

WE REMOVE THE IRON ROD AND SET A 1" X 30"  
IRON PIPE, 27" IN THE GROUND FOR THE  
CLOSING CORNER, WITH BRASS CAP ATTACHED,

MARKED:

DOUGLAS CO. SURVEYOR

T 225

R		R
11	S 12	S 6
W	S 7	W

1976

WE PLACE THE IRON ROD ALONG THE EAST  
SIDE OF THE BRASS CAP.

NOTE:

THIS CORNER IS LOCATED APPROX. 20 FT  
WEST OF A RIDGE <sup>TOP</sup> RUNNING N 20° W AND  
S 20° E.

COMPASS DECLINATION SETTING: 20° EAST

10-25-76

Larry J. Earle  
PETER L. EARLE

C. S. File No. 59/24