

RENEWAL

10-26-76

T 23 S

R 525	R
1	S 31
W 536	E

FOUND

1. STONE, 6X10X8 INCH, S 25 ON  
NW FACE, S 36 ON SW FACE,  
4 NOTCHES ON NORTH EDGE (REC.  
S), AND 1 NOTCH ON SOUTH EDGE.

2. HEMLOCK S NOW 12 INCH DIAMETER  
BEARS N 86° E, 24 ± FEET.  
SCRIB OBLITERATED IN 1925  
RESURVEY.

3. HEMLOCK B NOW 16 INCH DIAMETER  
BEARS S 23° E, 17 ± FEET (REC.  
18 ± FEET). SCRIBE OBLITERATED  
IN 1925 RESURVEY.

4. HEMLOCK B INCH DIAMETER BEARING  
S 6° W, 21 ± FEET, UPROOTED  
AND BADLY ROTTED. SCRIBE MARK  
FOUND "S".

#7 T23-1W ✓

#2 T23-1E ✓

C. S. File No. 59/24 C

8" HEMLOCK

N35° W

T23 SRIW

$$17.9 @ 14^\circ = 17.1$$

.9703

17.9

87327

67921

9703

17.36837

NORTH WEST BEARING TREE NOT  
FOUND.

RENEWAL

1. SET 30" X 1" DIA. IRON PIPE WITH  
BRASS CAP AT CORNER POINT.  
CAP IS STAMPED;

"DOUGLAS COUNTY SURVEYOR"

	T	23	S	
R	325		331	R
W	336			E

1976

PLACE ORIGINAL STONE MONUMENT  
ON WEST EDGE OF CAP.

2. A HEMLOCK, 8 INCHES DIAMETER  
BEARS N 35° W, 17 ± FEET.  
TREE DOUBLE BLAZED AND SCRIBED  
"T 23 S R 1 W 325 CORNER".

THERE ARE NO SUITABLE TREES TO SCRIBE  
IN SOUTH QUAD.

MAG. DEC. 20° E.

10 - 26 - 76

L. E. MONREAN

C.S. File No. 59/2A-44 P. L. EARLE

RECOVERY NOTES


PROPERTY CORNER INVESTIGATION

LOCATION

T. 23S R. 1W

Mer. WILL State ORE

Forest UMPO Dist. C.G.

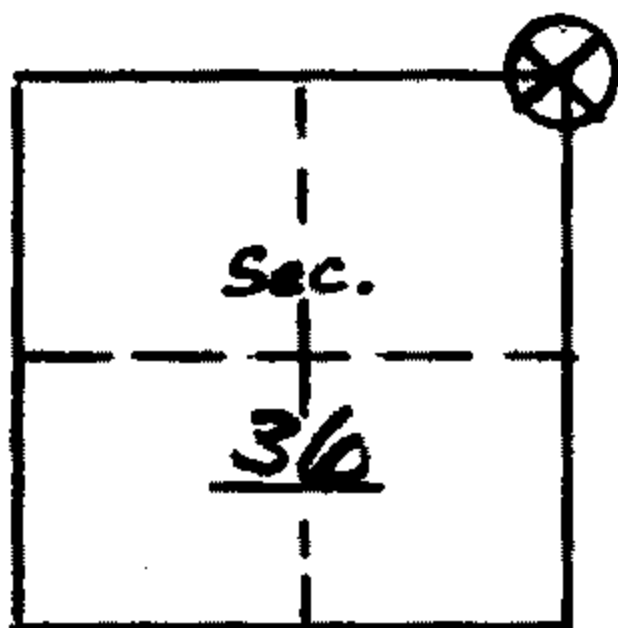

LEGEND

- Corner searched-no evidence
- ⊗ Corner or accessory found
- Corner marked by perm. mon.

DESCRIPTION OF FOUND CORNER

MATERIAL: STONE SIZE: 10 x 8 x 6

HEIGHT ABOVE GROUND: UNDER CONDITION: GOOD

MARKINGS: "25" ON NW FACE AND "36" ON SW FACE

DESCRIPTION OF FOUND ACCESSORIES

10" (ORIG 5") HEMLOCK BEARS N86°E, 24.42'  
 12" (ORIG 8") HEMLOCK BEARS S23°E, 18.48'  
 BOTH PREVIOUSLY OPENED. SCRIBING  
 REMOVED IN 1925 RESURVEY.  
 ORIG. S.W. B.T. IS DOWN. OPEN  
 & FIND SCRIBING & REVERSE. (OVER)

NOTE: Indicate full investigative details on back of form.

PHOTO IDENTIFICATION

Symbol & date \_\_\_\_\_ Line or Roll \_\_\_\_\_ Exposure \_\_\_\_\_

How Identified \_\_\_\_\_ Where filed \_\_\_\_\_

RECOVERED BY: D. GAYLORD

DATE: 6/18/76

TITLE: CIVIL ENGR TECH

ROTTED REMAINS OF DRIB 30"  
HEMLOCK STUMP BEARS N 35° W,  
21.12', SEE THE 1925

RESURVEY FIELD NOTES FOR  
CORRECT BEARING TREE DESC-  
RIPTIONS.