

T235
 $\frac{1}{4}$ 36 P
 4 1 W
 T245

FD:

~~THE~~ ORIGINAL BEARING TREES AS FOLLOWS:
 BOTH

AN ORIG. 12" ~~NOW~~ HEMLOCK, NOW 24", DOWN
 AND ROTTEN, WITH ILLEGIBLE SCRIBE MARKS
 VISIBLE ON A PREVIOUSLY OPENED BLAZE.

AND AN ORIG. 30" NOW 36" HEMLOCK, ALIVE AND
 IN GOOD CONDITION WITH ILLEGIBLE SCRIBING
 VISIBLE ON PREVIOUSLY OPENED BLAZE.

THE ORIGINAL CORNER POST IS GONE.

AT THE CORNER POINT AS DETERMINED BY
 THE FOUND ORIGINAL BT'S AS FOLLOWS:

A DOWN 24" HEMLOCK BEARS $N 16\frac{3}{4}^{\circ} W$
 27 $\frac{1}{2}$ FT.,

AND A 36" HEMLOCK BEARS $S 76\frac{1}{2}^{\circ} W$
 29 FT..

#115 T24-1 ✓
 #97.23-1W ✓

WE SET A 1" X 30" IRON PIPE, 26" IN THE GROUND
ON A STEEP EAST SLOPE APPROX. 30 FT. WEST
OF A SMALL RAVINE, WITH BRASS CAP
ATTACHED, MARKED:

DOUGLAS CO. SURVEYOR

T 23 S

1/4 S 36 R
4 S 1 1
W

T 24 S

1976

FROM WHICH WE MARK THE FOLLOWING
NEW BT.

A 6" HEMLOCK BEARS N 40 1/2° E 9 2 FT.,
SCRIBED "1/4 S 36 CS BT" ON A
SINGLE BLAZE.

COMPASS DECLINATION

10-28-76

SETTING: 20° EAST

Harry J. Langley

A. VIC CANBE

OK ~~ML~~

MIKE L. TOMPKINS

DIETZGEN NO. 385-6

RECOVERY NOTES


PROPERTY CORNER INVESTIGATION

LOCATION

T. 235 R. LW

Mer. WILL State ORE

Forest UMPA Dist. C.G.

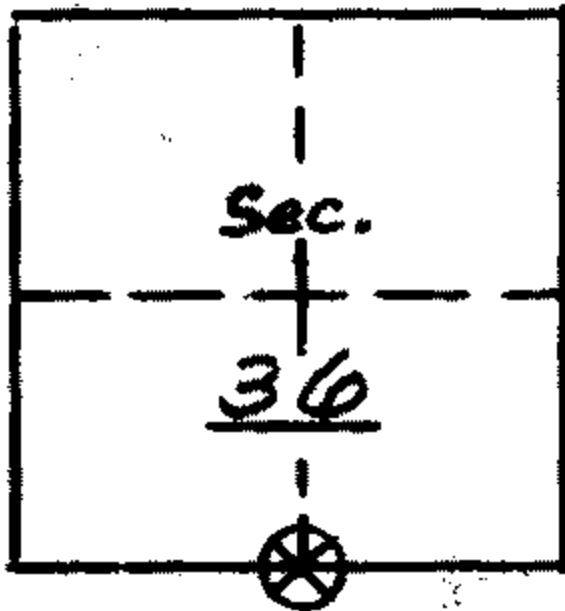

LEGEND

- Corner searched-no evidence
- Corner or accessory found
- Corner marked by perm. mon.

DESCRIPTION OF FOUND CORNER

MATERIAL: NONE SIZE: _____

HEIGHT ABOVE GROUND: _____ CONDITION: _____

MARKINGS: _____

DESCRIPTION OF FOUND ACCESSORIES

18" (ORIG 12") DOWN HEMLOCK. CHOP OUT & FIND FAINT SCRIBING. (N16°45'W, 27.72')

42" (ORIG 30") HEMLOCK BEARS S76°30'W, 29.04' PREVIOUSLY CHOPPED OUT. SCRIBING

VISIBLE. PLACED B.T. TAG ON TREE.

CORNER LIES 30' WEST OF SMALL DRAW NOT CALLED IN G.L.O. SURVEY NOTES.

NOTE: Indicate full investigative details on back of form.

PHOTO IDENTIFICATION

Symbol & date _____ Line or Bolt _____ Exposure _____

How Identified _____ Where filed _____

RECOVERED BY: D. GAYLORD

DATE: 5/21/76

TITLE: CIVIL ENGR. TECH.