

RENEWAL

11-3-76

T 29 S R 1 E

S 33 | S 34

S 4

T 30 S R 1 E

FOUND

1. A U.S. GENERAL LAND OFFICE  
SURVEY BRASS CAP, STAMPED;

" " "

T 29 S | R 1 E

S 33 | S 34

T 30 S R 1 E

S 4

1937

CAP FIRMLY SET IN MOUND  
OF STONE.

2. A FIR 15 INCH DIAMETER NOW  
A SNAG, BEARS N 20 1/2° E,  
28 ± FEET (REC N 23° E,  
26 ± FEET), TREE HAS WELL HEALED  
BLAZE

T. 29-1E ✓  
# 133 ✓  
# 32 T 30-1E ✓

59/26 C  
E.S. File No. 59/26 C

DATE PAGE NO. SERIES

FOUND

3. A FIR 7 NOW 12 INCHES DIAMETER  
BEARS N 14° W, 15<sup>±</sup> FEET (REC.  
N 12° W, 13<sup>±</sup> FEET), TREE HAS  
WELL HEALED BLAZE

RENEWAL.

AN I. CEDAR 13 INCHES DIAMETER  
BEARS N 34½° E, 32<sup>±</sup> FEET.  
TREE DOUBLE BLAZED AND SCRIBED  
"T 29 S R I E S 34 CS BT"

MAGNETIC DECLINATION 20° E

11-3-76

L. E. MONROE

P. L. EARLE

OK  
*[Signature]*

C. S. File No. 59/26

RECOVERY NOTES


PROPERTY CORNER INVESTIGATION

LOCATION

T. 29S R. 1E

Mer. WILL State ORE

Forest UMPR Dist. TILLER

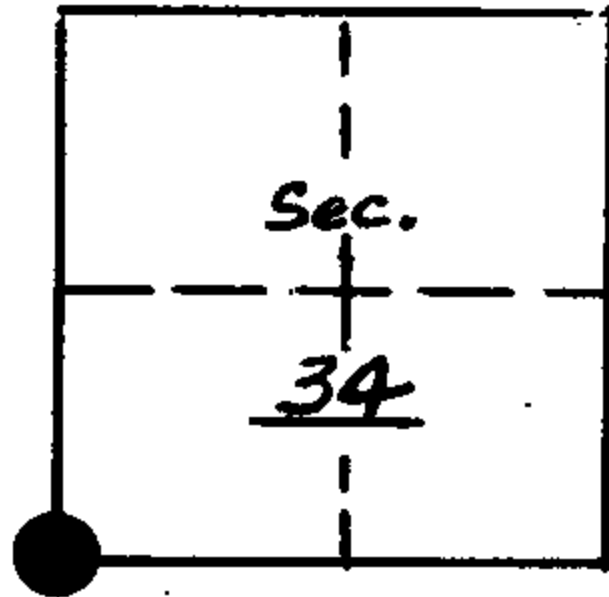

LEGEND

- Corner searched-no evidence
- Corner or accessory found
- Corner marked by perm. mon.

DESCRIPTION OF FOUND CORNER

MATERIAL: BRASS CAP SIZE: 1 1/2" DIA

IN MOUND OF STONES

~~HEIGHT ABOVE GROUND:~~ 2' x 3' x 5' CONDITION: GOOD

MARKINGS: T29S R1E S33 S34

T30S R1E S4 1937

DESCRIPTION OF FOUND ACCESSORIES

20" FIR SNAG WITH HEALED BLAZE BEARS  
N23°E, 26.4'

24" FIR WITH HEALED SCAR BEARS S18°E,  
25.74'

16" FIR SNAG WITH PARTLY HEALED BLAZE.  
NO SCRIBING - OBLITERATED PER 1910 NOTES.  
BEARS S30°W, 35.64'

8" FIR WITH HEALED BLAZE BEARS N12°W, 13.2'

NOTE: Indicate full investigative details on back of form.

PHOTO IDENTIFICATION

Symbol & date \_\_\_\_\_ Line or Roll \_\_\_\_\_ Exposure \_\_\_\_\_

How Identified \_\_\_\_\_ Where filed \_\_\_\_\_

RECOVERED BY: D. GAYLORD

DATE: 8-13-76

TITLE: CIVIL ENGR. TECH.