

11/16/76

# 295 R 2W

S 29 | S 28

S 32 | S 33

①

1917

FOUND:

A 2" I.P. FIRMLY SET WITH BRASS CAP STAMPED AS ABOVE. THIS MONUMENT IS IN GOOD CONDITION.

WE ALSO FIND AN ORIGINAL 18" NOW 27" FIR BEARS N 66 1/2° E; 25.7' HEALTHY AND SHOWS GOOD SCAR.

AN ORIGINAL 14" NOW 20" CEDAR BEARS S 79° E; 25.1'. HEALTHY AND SHOWS GOOD SCAR.

AN ORIGINAL 24" NOW 38" FIR BEARS S 45 1/2° W; 68.6'. HEALTHY AND SHOWS GOOD SCAR.

AN 18" FIR WINDFALL THAT FITS REASONABLY WELL FOR BEARING AND DISTANCE FOR THE ORIGINAL N.W. BEARING TREE BUT WE FIND NO EVIDENCE TO VERIFY IT AS A B.T.

DILTZGEN NO. 385-6

# 96v

U.S. File No. 56/26-14

C

11/16/76

FT 295 R2W

S29 S28

S32 S33

(2)

1917

NEW TREES:

A 10" W. FIR BEARS N9W; A 10'  
MARKED "T295 R2W S29 CS BT" IN  
A DOUBLE BLAZE.

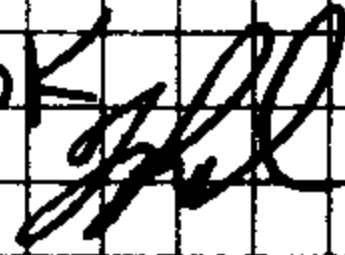
NOTE:

WE STAMP "CS 1976" ON FOUND  
BRASS CAP.

COMPASS DEC. 20° E

A. V. ~~Carrie~~

MIKE TOMPKINS

OK 

S. File No. 56/26

DIETZGEN NO. 385-6