

RENEWAL

12-6-76

T. 28 S R 7 1/2 W

56
57

SEE RENEWAL # 7

FOUND

1. A 2 INCH DIAMETER IRON PIPE  
WITH BRASS CAP ATTACHED, CAP  
IS STAMPED;

" U. S. GENERAL LAND OFFICE SURVEY

T 28 S
56
57
R 7 1/2 W

1324

CAP IS FIRMLY SET.

2. A 20 INCH DIAM. LAUREL  
NOW BROKEN AND LAYING ON  
GROUND. STUMP BEARS S 53° W,  
14 1/2 FEET (REC 13 ± FEET).

3. A 12 INCH DIAM. FIR NOW  
BROKEN AND LAYING ON  
GROUND. STUMP BEARS N 31° W,  
29 ± FEET (REC. 28 ± FEET).

#15 ✓

U. S. File No. 59/28 <sup>26-19</sup> C

DIETZEN NO. 385-B

RENEWAL

T 285 R 7 1/2 W  
56  
57

FOUND

- 1. A 12 NOW 19 INCH DIAM CEDAR BEARS N 28° E (REC. N 22° E), 4 3/4 FEET. TREE BLAZED, PARTIALLY HEALED, SOME SCRIBING VISIBLE. (Per # 7)

RENEWAL

- 1. A CEDAR 10 INCHES DIAM. BEARS S 23° W, 65 3/4 FEET. TREE DOUBLE BLAZED AND SCRIBED "T 285 R 7 1/2 W S 23 CS BT".

- 2. A D. FIR 13 INCHES DIAM. BEARS N 28 1/2° W, 52 1/2 FEET. TREE DOUBLE BLAZED AND SCRIBED "T 285 R 7 1/2 W S 6 CS BT".

MAG. DEC. 20° E

12-6-76

*Jerry / Moore*

P. L. EARLE

K. CHENEY

OK *[Signature]*

DIETZEN NO. 385-6


Jan. 1963

LOCAL RECORD

DEPARTMENT OF THE INTERIOR  
BUREAU OF LAND MANAGEMENT

CORNERS OF THE CADASTRAL SURVEY GRID

T. 285 R. 7 1/2 W., W.M. Mer., Oregon State.

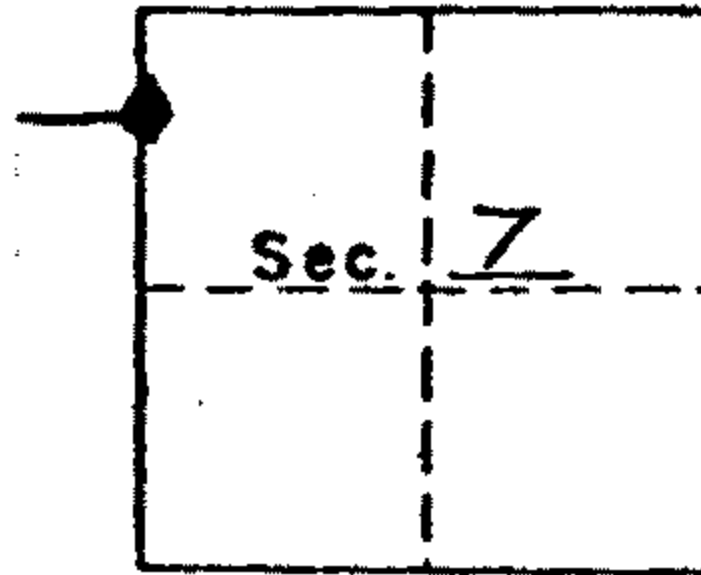

SYMBOLS

- ◆ Official corner found
- ◇ Probable corner found, authenticity doubtful.
- Corner searched for and not found.

Reported By John H. Ruge  
Forester

S. C. E. T. FHWA  
Title

3-15-76  
Date

MARKS: \_\_\_\_\_

S.C. Corner common to Secs. 6 & 7 of R 7 1/2 W & \_\_\_\_\_ is a mound of stone, tree, fire pit, iron pipe, W 2 1/2" Brass cap size 1 1/2" T.P. 7" above ground

LEGIBLE MARKS ON BEARING OBJECTS

	<sup>789 1202</sup> S 28° W Dist. 4.0 R 7 W scribing NOT Yndable	<sup>789 1203</sup> N 52° E Dist. 10.0 T 285 R 7 1/2 W S.C. 7		
	B.T.	BT *		
KIND	Lead	Downed Dead material		
SIZE	13"	19"		
BEARING	S 31° W	S 64° W		
DISTANCE	4.2	10.1		
BT TAG	2-64	9-57		
POSTED BY	E + K	Adams		

ADDITIONAL INFORMATION

\* tag nailed on Madison after it fell. All dist. & brgs to tag.

Brass cap leads;  
U.S. General Land office  
T 285 1924

Sec. 6  
" 7

R 7 1/2 W

see  
back  
this c.  
for loc.  
tion  
map.

G.S. File No. 59/26

(OVER)

Need  
BT