

12-9-76

T T 24 S RIW

S 33
 ——— E 1/16
 S 4

T 255

SEE CS. FILE M 32-62

FOUND

1. A 3/4 INCH DIAMETER BY 36 INCH
 STEEL TUBE WITH A 2 1/2 INCH
 DIAMETER ALUMINUM CAP, CAP
 IS STAMPED

" U. S. P. C. PROPERTY COR. "

T 255 RIW

33
 ———
 4 E 1/16

RE 4287

STEEL TUBE IS BENT, CAP IS
 16 INCHES ABOVE GROUND.
 AREA DISTURBED BY LOGGING.

A RED CEDAR 8 INCH DIAMETER

2.

NOW A STUMP, BEARS S 71° W,

14 FEET (REC S 70° W 9 FEET)

STUMP SCRIBED "BT".

G.S. File No.

59/26-2C

#129
T25-1
#24-1
#120

RENEWAL

T 24 S R1W
33 E 1/6
T 15 S

(2)

N E BEARING TREE NOT FOUND.

RENEWAL

DUE TO THE CONDITION OF THE MONUMENT (BENT & LOSE) AND THE TIE TO THE S W BEARING TREE I DETERMINE THAT THE MONUMENT HAS BEEN DISTURBED.

I REMOVE THE CORNER MONUMENT AND ~~REPLACE~~ IN THE POSITION WHERE I FOUND IT, AN IRON ROD 3/4 INCH DIAMETER, 30 INCHES LONG, 27 INCHES IN THE GROUND.

I SET MONUMENT, MARKED AS NOTED (FOUND # 1), AT CORNER AS DETERMINED BY T.E. SHRUM JR, M 32-62 AS RECORDED, FROM WHICH 8 INCH DIAMETER RED-CEDAR STUMP BEARS S 70° W, 9 1/2 FEET.

DIETZGEN NO. 385-6

S. File No. 59/26

RENEWAL

1145 210
B3
4
E 1/16
T 255

(3)

3/4 INCH DIAM. IRON ROD
BEARS N 80° E, 4 1/2 FEET

NEW B.T.

SET 3/8 BY 12 INCH STAR
DRILL 10 INCHES DEEP AT
CENTER OF A 48 INCH
DIAMETER HEMLOCK STUMP.
MARKER BEARS S 41 1/2° W,
31 1/2 FEET. STUMP BURNED
AND SCRIBED "1/16 S 4 CSDT"

MAGNETIC DECLINATION 20° E

12-9-76

Larry L. Munn

P. L. EARLE

NOTE: STAR DRILL USED FOR
REFERENCE MARK IS A 1/2 INCH
DRILL, SHANK PORTION MEASURES
3/8 INCH.


OK [Signature]

U.S. File No. 59/26

DIETZEN NO. 385-6

Section 93 Twp 245 Rge 1 W

Date: 11-15-76

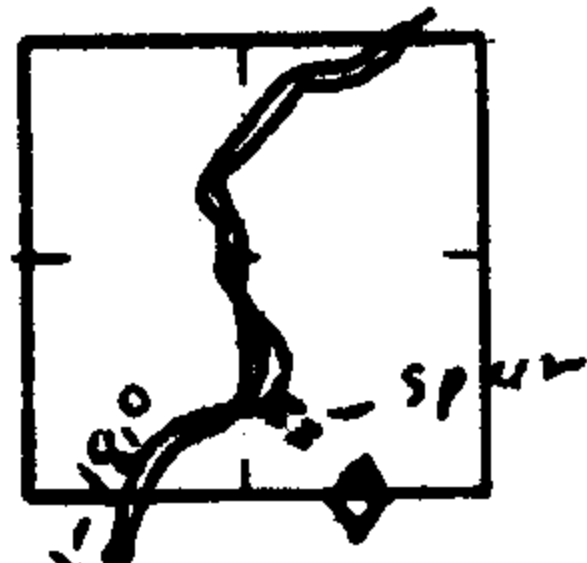

How was corner identified? Iron pipe & Aluminum cap

6" yew B.T. broken off with part of face still visible

Condition of corner: Iron pipe is bent but still in the ground

Best route to reach corner: go to the end of the spur road is SW & SE

See 33 and then walk down the ridge

| Quadrant | NE | NW | SE | SW |
|----------------------|----|----|----|--------------------|
| Species & Size | | | | 6" yew |
| Dist. & Bearing | | | | |
| Condition of Scribe | | | | Most of it is gone |
| Original or Resurvey | | | | |
| Appearance of B.T. | | | | broken off |
| Tags, Marks, etc. | | | | None |

Other Remarks:

this corner needs new witness trees marked.

Richard W. Baird

Signed

S. File No. 59/2