

12-20-76

9 | 10 T265 R3E
1/4

FOUND:

A 1" IRON PIPE LOOSELY SET AND EXTENDING
16" ABOVE GROUND, WITH BRASS CAP ATTACHED,

MARKED:

U.S. GENERAL LAND OFFICE SURVEY

1/4 53
310

1930

(NOTE: THE MONUMENT MARKINGS ARE ERRONEOUS
FOR THIS CORNER.)

FROM WHICH:

AN ORIGINAL BT, A 22" NOW 24" D. FIR, ALIVE
AND WELL HEALED, BEARS N 44° E 35° FT.,

AND AN ORIGINAL BT, A 30" D. FIR, NOW A 34"
SNAG, WITH SCRIBING "59 BT" VISIBLE ON
UNHEALED FACE, BEARS N 45° W 30° FT.

1 ✓

DITZGEN NO. 385-S

WE RESET THE FOUND MONUMENT 27° IN THE
GROUND, AND OBLITERATE THE ERRONEOUS
MARKINGS ON THE BRASS CAP. WE RESTAMP
THE MONUMENT TO READ AS FOLLOWS:

U. S. GENERAL LAND OFFICE SURVEY

T26S R3E

CS 1976

S9 | S10

$\frac{1}{4}$

1930

AND MARK A NEW BEARING TREE:

A 16" D FIR BEARS S $77\frac{1}{2}^{\circ}$ W 35 $\frac{3}{4}$ FT.,
SCRIBED " $\frac{1}{4}$ S9 CS BT" ON A DOUBLE
BLAZE.

COMPASS DECLINATION: 20° EAST

12-20-76

[Signature]

Larry J. Langley
MIKE TOMPKINS

KAREN CHENEY

G. S. File No. 59/26

RECOVERY NOTES


PROPERTY CORNER INVESTIGATION

LOCATION

T. 26 S R. 3 E

Mer. WILL State ORE

Forest UMPR Dist. D. L.

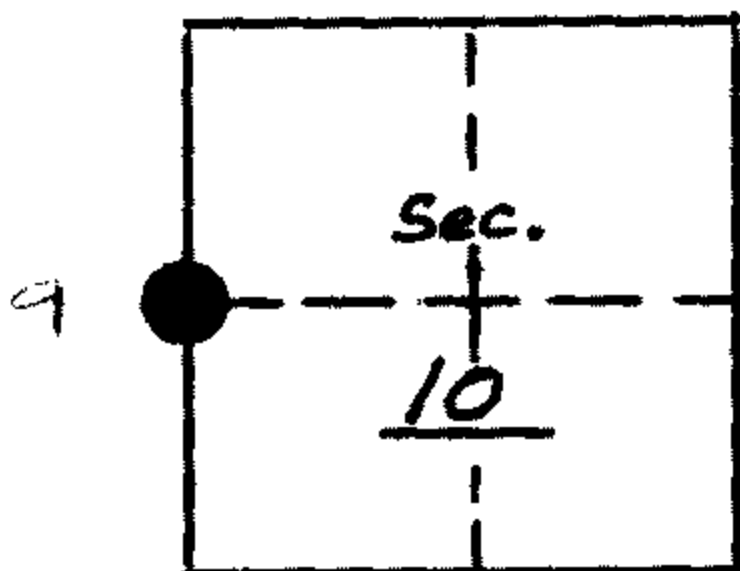

LEGEND

- Corner searched—no evidence
- ⊗ Corner or accessory found
- Corner marked by perm. mon.

DESCRIPTION OF FOUND CORNER

MATERIAL: BRASS CAP SIZE: 2 1/2"

HEIGHT ABOVE GROUND: 18" CONDITION: FAIR

MARKINGS: 1/4 S3 S10 1930 (NO TOWNSHIP OR RANGE)

BRASS CAP STAMPED INCORRECTLY

DESCRIPTION OF FOUND ACCESSORIES

22" FIR BEARS N 44° E, 34.98' WITH A WELL HEALED SCAR,

40" (ORIG 30") FIR BEARS N 45° W, 30.36' SCRIBING VISIBLE ON PARTLY HEALED BLAZE "S9 BT".

NOTE: Indicate full investigative details on back of form.

PHOTO IDENTIFICATION

Symbol & date _____ Line or Roll _____ Exposure _____

How Identified _____ Where filed _____

RECOVERED BY: D. GAYLORD

DATE: 8-30-76

TITLE: CIVIL ENGR TECH.