

12/22/76

#225 R6W

$$\frac{1}{4} \begin{array}{l} \text{S16} \\ \hline \text{S21} \end{array}$$

SEE REN # 124

FOUND:

BLM CADASTRAL BRASS CAP PROPERLY
MARKED AND FIRMLY SET AT TOE
OF ROAD FILL (22-6-15.0)

FROM WHICH:

A 30" FIR STUMP BEARS WSS $\frac{1}{2}$ E; 31.0'
WITH VISIBLE "S16" SCRIBING.

A 10" D. FIR SNAG BEARS N30W;
69.2' WITH "1/4 S16 CS BT" VISIBLE
ON UNHEALED BLAZE.

A WINDFALL 12" D. FIR BEARS N21E;
65.2' WITH VISIBLE "1/4 S16 CS BT"
ON UNHEALED BLAZE.

NEW TREES:

A 16" D. FIR BEARS N30W; 65.3'
MARKED "1/4 S16 CS BT" IN A DOUBLE
BLAZE.

CONTINUES ON PG. 2


C.S. File No: 59/26-24

#131 ✓

C

12/22/76

VT22S R6W

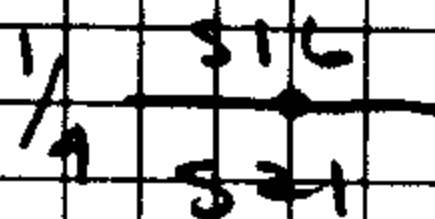

(2)

SEE PEN # 124

A IS D. FIR BEARS N33W, 94.6'
MARKED "1/4 SIC CS BT."

NOTE:

THERE ARE NO AVAILABLE TREES
TO SCRIBE IN SECTION 21 AS
AREA IS IN CLEAR CUT.

CORNER IS APPROX 30' NORTH
OF BLM ROAD # 22-6-15.0

COMPASS DEC 70° E

A. J. [unclear]
MIKE TOMPKINS
KAREN CHENEY

OK
[Signature]

G. S. File No. 59/26

DIETZEN NO. 388-6