


RENEWAL

1-3-77
~~12-21-76~~

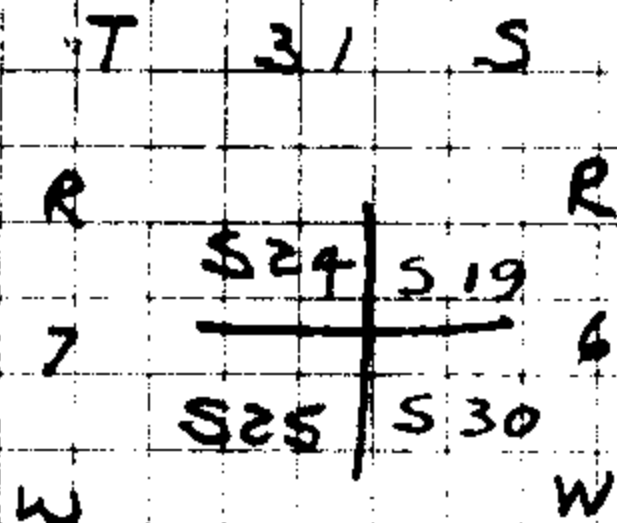

SEE RENEWAL 6 (R 7 W) & 41 (R 6 W)

FOUND

1. 1/4 INCH DIAM. IRON PIPE FIRMLY SET AT SECTION CORNER AS DETERMINED BY JOHNSTON 1962 SEE C.S. FILE M 18-66.

2. 6" NOW 10" DIAM. D. FIR BEARS S 88° W 30[±] FEET (REC 32[±] FEET). TREE HAS WELL HEALED BLAZE (SINGLE).

3. 14" NOW DEAD, TIPPED OUT D. FIR BEARS S 63° E, 35[±] FEET. TREE HAS OPEN DOUBLE BLAZE SCRIBED "TSIS 6 W S 30 BT".

4. 30" NOW 31" D. FIR BEARS N 10° E, 54[±] FEET (REC. 55[±]). TREE HAS PARTIALLY HEALED SINGLE ~~STUB~~ BLAZE.

#99 T31-7 ✓
#135 T31-6 ✓

C.S. FILE No. 59/29-10

FOUND

5. 7" NOW 9" S. PINE BEARS N 55° W,
23² FEET (REC. 23² FEET). TREE HAS
WELL HEALED DOUBLE BLAZE.

RENEWAL

1. I PLACE 1" X 30" IRON PIPE, WITH
BRASS CAP, ATTACHED, AT SECTION CORNER AS
DETERMINED BY JOHNSTON, CAP IS
STAMPED

" DOUGLAS COUNTY SURVEYOR "

T 31 S

R		R
	S 24 / S 19	
7	<hr/>	6
	S 25 / S 30	
W		W

1977
~~1976~~

2. AN S. PINE 15 INCH DIAM. BEARS
S 69° E, 53² FEET. TREE DOUBLE
BLAZED AND SCRIBED "T31SR6WS30
CS BT".

NOTE ALL BEARINGS AND DISTANCES MEASURED
ARE TO CENTER OF BASE OF TREE.

C. S. File No. 59/29-1

DREYER NO. 359-6

MAGNETIC DECLINATION 20° E

1-3-76

~~Larry E. Monrean~~

LARRY E. MONREAN

K. CHENEY

P. L. EARLE

OK
Earle

DISTRICT NO. 3856

C. S. File No. 59/29-1