

RENEWAL

1-12-77

\$17	\$16
S20	S21

T29 S R7W

Ren # 59-67
6 1957 GLO

FD: A IRON PIPE 2 IN. IN DIAM.
FIRMLY SET WITH BRASS CAP
MARKED:

COUNTY SURVEYORS OFFICE

T29 S R7W

\$17	\$16
S20	S21

1954

A IRON PIPE 2 IN. IN DIAM.
FIRMLY SET WITH BRASS CAP
MARKED:

U.S. G.L.O.
~~GOVERNMENT LAND OFFICE~~

T29 S R7W

\$17	\$16
S20	S21

1957

DIETZGEN NO. 385-6

232 ✓

G. S. File No. 59/29-9

RENEWAL

\$ 17 | SIL

1-12-77

S20 | S21

T29S R7W

FD: AN ORIG. 10 IN R. FIR (NOW
A 42 IN. SAWED STUMP
BEARS N. 20° E., 44.9 FT.
NO VISIBLE SCRIBING ON PREVIOUS
OPENED BLAZE.

THE S.E., N.W., AND S.W.
ORIG. BTS NOT FOUND.

FD: SEE RENEWAL # 64
TWO UNRECORDED BTS
NOT FOUND

A 10 IN R. FIR NOW A DOWN
10 IN FIR BEARS N. 52° E., 1 FT.
PARTIAL SCRIBING UNV. SIBL.

A 10 IN R. FIR NOW A 13 IN.
TIPPED OUT STUMP BEARS S. 58° E.,
18.7 FT. NO VISIBLE SCRIBING

C. S. File No. 59/29-9

RENEWAL

S17 / S16

1-12-77

S20 / S21

T295 R7W

FD: RENEWAL #64

A 10 IN. R. FIR NOW A 13 IN.
BEARS N. 75° W., 14.5 FT WITH
HEALED OVER DOUBLE BLAZE.

A 8 IN. R. FIR NOW A 9 IN. TAPPED
OUT STUMP BEARS S. 22° W., 25.8
FT. NO VISIBLE SCRIBING.

FD RENEWAL #84

A 16 IN. R. FIR NOW A 18 IN.
DOWN FIR BEAR S 38° E, 62 FT.
WITH HEALED OVER DOUBLE BLAZE.

A 5 IN. W. FIR (NOW A 16 IN.)
BEARS N. 24° W., 41.2 FT. WITH
HEALED DOUBLE BLAZE

RENEWAL

S17 / S16

1-12-77

S20 / S21

T295 RTW

FD. RESURVEY 1957

A 10 IN. FIR (NOW 19 IN. DIAM)

BEARS N. $38\frac{1}{2}^{\circ}$ E., 78.5 FT DIST.

HEALED OVER BLAZE

A 10 IN. FIR (NOW 13 IN. DIAM)

BEARS S. $41\frac{1}{2}^{\circ}$ E., 58.1 FT DIST.

WITH HEALED BLAZE

A 17 IN. FIR (NOW 21 IN. DIAM)

BEARS S. 88° W., 107.6 FT DIST.

WITH HEALED BLAZE

NOTE:

FD. UNRECORDED 19 IN FIR

STUMP BEARS N. $19\frac{1}{2}^{\circ}$ E., 23.2 FT

DIST. UNVISIBLE SCRIBING "BT"

A FENCE COR. BEARS N 77° E.,

1 FT DIST. SAID FENCE RUNS

EASTERLY AND SOUTHERLY.

C. S. File No. 59/29-9

RENEWAL

S17 / S16

1-12-77

S20 / S21

T29S R7W

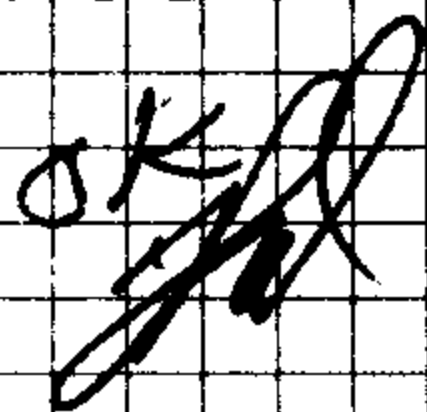
MAGNETIC DECLINATION 20° EAST

1-15-77

L. E. MONROE

Kenneth Cherry

P. L. EARLE

OK


DIETZGEN NO. 385-6

C. S. File No. 59/29-9