

FOUND OK

1-13-77

T 29S R 7W

1/4

517/516

SEE RENEWAL #63

FOUND

1. A 1" X 30" IRON PIPE WITH BRASS CAP ATTACHED, CAP IS STAMPED;

" COUNTY SURVEYORS OFFICE "

T 29S R 7W

517/516

1954

CAP IS APPROXIMATELY 1 FOOT ABOVE GROUND.

2. A R. FIR 20 NOW 30 INCHES DIAM.

BEARS N 41° W, 16^S FEET TO FACE, 18° FEET TO CENTER (ORIG. N 46° E, RENEWAL #63 REC N 46° W). TREE HAS PREVIOUSLY OPENED BLAZE, SCRIBE VISIBLE "BT".

#233 ✓

C. S. File No. 59/29-120

DIETZGEN NO. 385-6

FOUND OK

FOUND

3. A B. OAK 12 NOW 17 INCH DIAM
BEARS N 21° W, 17² FEET. TREE
HAS WELL HEALED DOUBLE BLAZE.

4. A B. OAK 6 NOW 10 INCH DIAM
BEARS N 39° E, 26² FEET. TREE
HAS WELL HEALED DOUBLE BLAZE.

5. FOUND REMAINS OF ROTTEN AIR STUMP BEARS N 46° E
19² FEET (REC. 19²) NO SCRIBING FOUND.
MAGNETIC DECLINATION 20° E

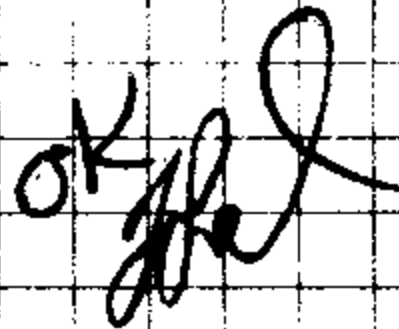
1 - 13 - 77

~~Jerry L. Moore~~

KAREN CHENEY

PETE EARLE

NOTE: CAP IS APPROX 1² FEET
SOUTHERLY OF A FENCE RUNNING
GENERALLY EAST AND WEST.

OK 

C. S. File No. 59/29-12