


1-24-77

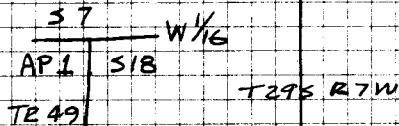


FOUND:

A 1" I PIPE, FIRMLY SET, EXTENDING 8" ABOVE GROUND WITH BRASS CAP ATTACHED,

MARKED:

U.S. GENERAL LAND OFFICE SURVEY

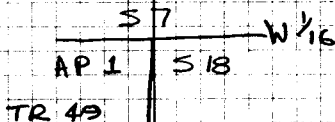

1924

FROM WHICH THE ORIGINAL BEARING TREE;

AN ORIG. 7" NOW 18" D. FIR, ALIVE AND WELL HEALED BEARS S 44° W 25¹/₂ FT.

WE MARK A NEW BT AS FOLLOWS:

A 7" G. FIR BEARS S 38¹/₂° E 50¹/₄ FT., SCABBED

" W 1/16 S 18 CS BT" ON A DOUBLE BLAZE.

COMPASS DECLINATION SETTING: 29° EAST

1-24-77

G.S. File No. 59/29-140K

Gary J. Stangor
Peter L. Enloe

#225 ✓

CITIZEN NO. 385-6

~~LS 2 21 51⁵ LVL~~

~~SS 8 21 52⁴ LVL~~

NEW BT

~~_____~~

" N 16 318 CS BT "

6" G. Fir

S 38¹/₂° E 50⁴ LVL