

T 29 S R 7 W

TR S 2

AP 4	S 18	W $\frac{1}{16}$
S 19		

FOUND

1. IRON PIPE 1" X 36" WITH U.S. GENERAL LAND OFFICE SURVEY BRASS CAP ATTACHED. CAP IS STAMPED

" " "

TR S 2		
AP 4	S 18	W $\frac{1}{16}$
S 19		

1924

CAP IS 27 INCHES ABOVE GROUND.

2. REMAINS OF ROTTED OAK, SIZE INDETERMINATE, DISLODGED AND LAYING DOWNHILL FROM ORIGINAL POSITION. THE BASE OF THE TRUNK BEARS 8° N 36½° W, 27<sup>2</sup> FEET (REC N 44° W). NO SCRIBING FOUND.

T29 S R T W

(2)

TR 52

AP 4

S 18


W 1/16

RENEWAL

S 19

1. AS CAP IS 27 INCHES ABOVE  
 GROUND I REFERENCE POSITION  
 OF MONUMENT AND RELOCATE IT  
 4 INCHES ABOVE GROUND AT  
 THE EXACT POINT WHERE FOUND  
 AND REFERENCED.

FROM WHICH

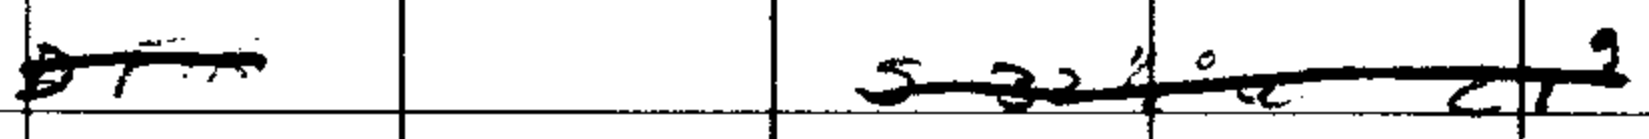

A D. FIR, 17 INCHES DIAMETER

BEARS S 32 1/2° W, 21 9/16 FEET.

TREE DOUBLE BLAZED AND SCRIBED

"W 1/16 S 19 CS BT"

A D. FIR 12 INCHES DIAM. BEARS

N 4 1/2° W, 48 1/16 FEET. TREE DOUBLE

BLAZED AND SCRIBED "AP 4 TR 52 CS BT"

MAG. DEC. 20° E

C.S. FILE NO. 59/29-21 P.L. EARLE

2-2-77 Larry M. M...

Handwritten signature

DIETZEN NO. 385-1-B