


T285 R5W

DATE: 2-23-77

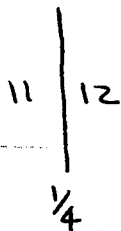

- Condition Report Only
- Not Found
- Renewed
- Unrecorded
- Surveyed In
- Referenced Out

Previous Renewal #'s 59, 128

Monument(s) Found: (Condition and Source) _____

MONUMENT SET BY SURVEY IN 1957 (REN. # 59) AND FOUND IN 1962
(REN. # 128) NOT FOUND AT THIS TIME!

Accessories Found: (Condition and Source) _____

Found 12" NOW 16" FORK OF W. OAK (30" DIAMETER TREE AT BASE)

ALIVE WITH WELL-HEALED DOUBLE BLAZE (REN. # 59)

THE SE BEARING TREE NOTED IN REN. # 59 HAS BEEN DESTROYED.

FOUND PER REN. # 128:

A 28' NOW 30" W. OAK ALIVE WITH WELL-HEALED DOUBLE BLAZE,

#143 ✓

AND A $\frac{3}{4}$ " I. ROD SET IN A N-S FENCELINE

RENEWAL

Monument Set: (Procedure and Description) IN ACCORDANCE WITH THE
FOUND ACCESSORIES AS DETAILED LATER, WE SET A 1" X 30" IRON PIPE, BURIED

12" BELOW GROUND LEVEL WITH BRASS CAP ATTACHED, MARKED:

DOUGLAS CO. SURVEYOR

T285 R5W

S 11 | S 12

FOUND
NEW Accessories: (Description)

$\frac{1}{4}$
1977

FROM WHICH:

A 16" FORK OF A W. OAK BEARS S 74° W 162⁰ FT., (REC. S 75° W 162⁰ FT.)

A $\frac{3}{4}$ " I. ROD BEARS S 74° W 41³/₄ FT., (REC. S 75° W 41³/₄ FT.)

A 30" W. OAK BEARS S 16° W 340⁷/₈ FT., (REC. S 16° W 342³/₈ FT.)

Location and Comments:

CORNER LOCATED IN OPEN
PASTURE, BOTH BT'S ARE
WESTERLY OF TUCKER
CREEK.

20° EAST

DOUGLAS CO. SURVEYOR

GARY LANGLITZ

Gary J. Langlitz

STEPHEN J. FLAUSE

Compass Declination

Agency

Party Chief

Notekeeper

Witnesses


OK
[Signature]

RUSHA

CORNER RENEWAL REQUEST

Section 11 Twp. 28 Rge. 5

Date 2-22-99

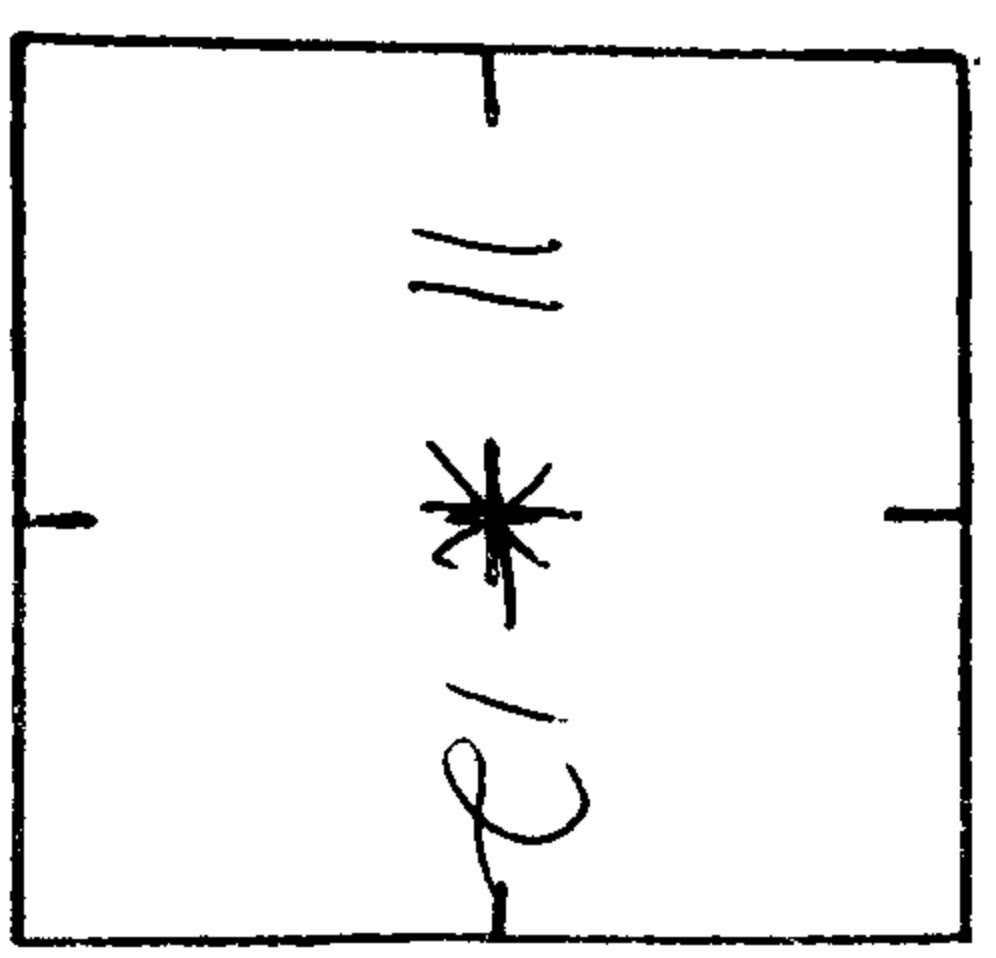

Condition of Corner and Accessories: BRG. TREES GOOD. FARMER DECIDED

TO PULL UP CAP CAUSE OF DISTURBING HIS FIELD.

M.L.P. IS HINDING ON B. CAP BEING RE-ESTABLISHED.

TX. LOT 4 T. 28 S. R. 5 W. S. 12

TO REACH: (Please show approximate distances, clearcuts, roads, fences, etc.)

GARY: SEE ME AS TO WHEN I CAN BE MADE THRU - D

Notify immediately prior to renewal visit? Yes X No

Notify following renewal visit? Yes No

Is corner in immediate danger of being lost or disturbed? Yes No

Name M. PARKER

Address H. BALL

Telephone

545 SE CLERK

ADDITIONAL COMMENTS EARLE

EARLE

673-5016