

DATE: 2-24-77

T285 R7W

$\frac{1}{4} \frac{14}{23}$

Condition Report Only
 Not Found
 Renewed
 Unrecorded
 Surveyed In
 Referenced Out

Previous Renewal #'s 70, 163

Monument(s) Found: (Condition and Source) _____

SANDSTONE SET BY FREAK (REN.#70) IN 1917 NOT FOUND

BRASS CAP SET BY BYRON (REN.#163) IN 1961 FOUND LYING ON
THE GROUND.

Accessories Found: (Condition and Source) _____

FD: THE ONLY REMAINING ORIGINAL BT, AN ORIG. 15" NOW 25" W. OAK,

PREVIOUSLY OPENED BY BYRON, PIECES OF WOOD WITH ILLEGIBLE

REVERSE SCRIBING FOUND NEAR BASE OF BT.

A 20" NOW 23" T. CEDAR WITH SCRIBING "1/4 S14 CS BT" VISIBLE ON

AN UNHEALED SINGLE BLAZE (REN.# 163)

AND A 10" NOW 12" B. OAK, ALIVE AND WELL-HEALED (REN.# 163)

RENEWAL

Monument Set: (Procedure and Description) We add the markings

"RESET" 1977 TO ~~THE~~ A BRASS CAP ATTACHED TO A 1" X 30" I. PIPE, PREVIOUSLY

MARKED COUNTY SURVEYORS OFFICE AND SET THE MONUMENT 22" IN THE GROUND AT THE POSITION

T285 R7W
1/4 514
4 523
1961

DETERMINED BY FREAR AS BEING

THE BEST POSITION TO RESOLVE THE CONFLICTS HE NOTES IN THE DISTANCES TO THE ORIGINAL BEARING TREES. (SEE REG. #70).

~~Now~~ Accessories: (Description)

FOUND

AN ORIGINAL BT, A 15" NOW 25" W. OAK BEARS S77°E 153⁸ FT. (REC. PER

ORIG. NOTES S77°E 158⁴ FT.) (REC. PER REG. #70, S77°E 153⁸ FT.)

A 23" I. CEDAR, PREVIOUSLY DESCRIBED, BEARS N 31¹/₂°E 85⁸ FT.

AND A 12" B. OAK, PREVIOUSLY DESCRIBED, BEARS N 31°W 34⁷ FT.

Location and Comments:

20° EAST
DOUGLAS CO. SURVEYOR
GARY L. LANGUITZ
Gary L. Languitz
STEPHEN J. FLAUS
GORDA TAYLOR

Compass Declination
Agency
Party Chief
Notekeeper
Witnesses


OK 

CORNER RENEWAL REQUEST

Section 14 23 Twp. 28 Rge. 7

Date 2-22-77

14
23

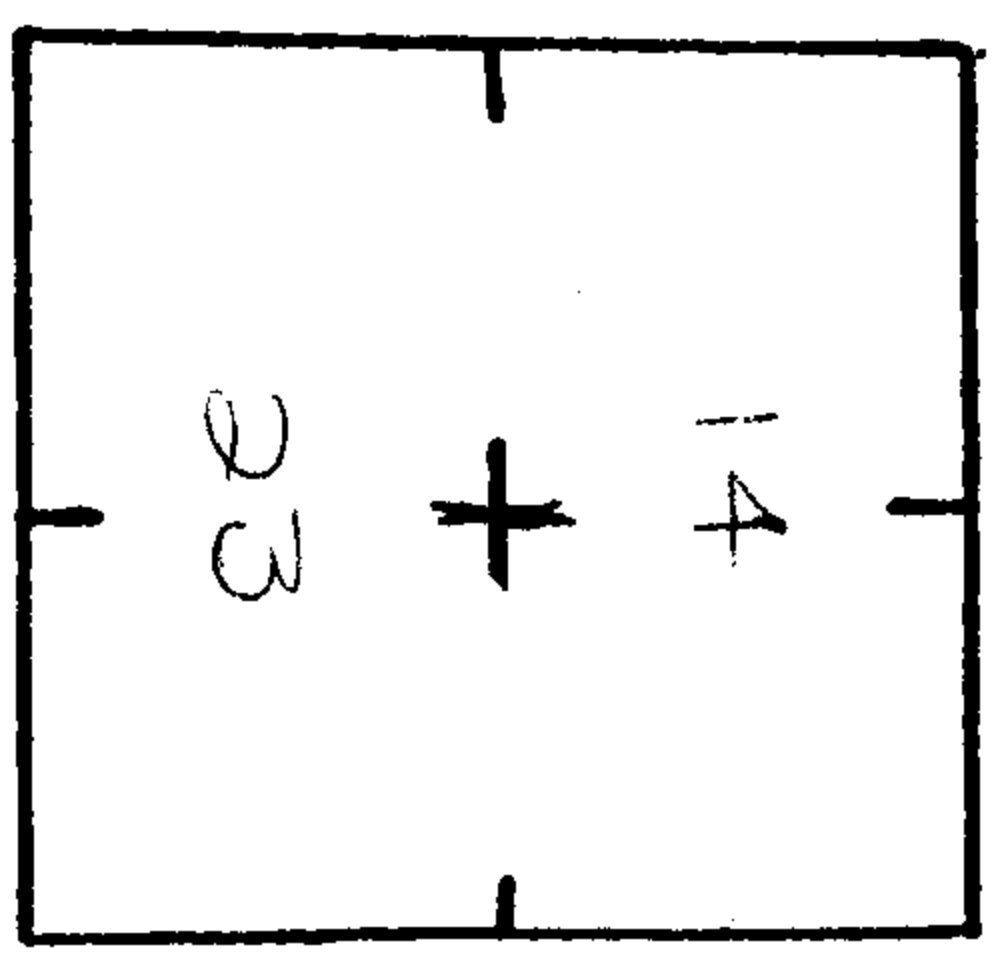

Condition of Corner and Accessories: BRG. TREES IN, PIPE PULLED OUT.

NEEDS PIPE REESTABLISHED. D. JOHNSTON PUT PIPE BACK IN HOPE
BUT WOULD LIKE A CREW TO RE-ESTABLISH THIS WK. IF POSSIBLE
SEE ME IF ANY QUESTIONS TOMORROW. CAUSE I HAVE TO LET HIM
KNOW. THANK-DEB

TO REACH: (Please show approximate distances, clearcuts, roads, fences, etc.) CO. RD. 108 BIVOU. PORTER

OR. E. LOOKING GLASS

Notify immediately prior to renewal visit? Yes No Name DEANUIS JOHNSTON

Notify following renewal visit? Yes No Address RD. DEPT.

Is corner in immediate danger of being lost or disturbed? Yes No Telephone _____

ADDITIONAL COMMENTS