

T 27 S R 7 W

DATE: 3-3-7

NNW  
DLC 43

Condition Report Only

Not Found

Renewed

Unrecorded

Surveyed In

Referenced Out

Previous Renewal #'s 20, 71, CS FILE 45/86

Monument(s) Found: (Condition and Source) NONE

Accessories Found: (Condition and Source)

1. ORIGINAL 10 INCH DIAMETER WHITE OAK NOW A ROTTED  
STUMP, FACE SPLIT AWAY, NO SCRIBING FOUND. STUMP

BEARS S 63 1/2 ° E 43 1/2 FEET.

RENEWAL NO. 20

2. A WHITE OAK 16 INCHES NOW DOWN AND ROTTED

BEARS S 35 ° E 50 ± FEET.

#185 ✓

C

RENEWAL NO. 71

3. A WHITE OAK 6 INCH DIAMETER NOW 8 INCH  
BEARS S 59° E 75 1/2 FEET (REC. S 60° E), TREE  
HAS WELL HEALED BLAZE.

RENEWAL

Monument Set: (Procedure and Description) SET 5/8" X 30 1/2" IRON ROD  
AT NNW CORNER DLC 43. ROD SET 7 INCHES BELOW  
SURFACE OF GRAVELED ROAD. SEE ATTACHED  
NARRATIVE.

New Accessories: (Description) NONE

Location and Comments:

20° EAST  
D.C.S.O.  
LARRY E. MONREAN  
Larry E. Monrean  
STEVE FLOUSE

Compass Declination  
Agency  
Party Chief  
Notekeeper  
Witnesses

T 27 S R 7 W

NNW. COR. DLC 43 IN SECTION 2

AS I FOUND THE S.W. CORNER OF DLC 44 TO BE UN-DISTURBED (PER REFERENCE WORK DONE BY POWELL 1973 CS 59/30) I OCCUPY THE CORNER (SW DLC 44) WITH DKM2-AE THEODOLITE AND TURN AN ANGLE LEFT  $135^{\circ} 23' 15''$  AND CHAIN THE RECORD DISTANCE (PER CS FILE 59/30) OF 68.45 FEET. AS I AM UNABLE TO LOCATE IRON PIPE OF RECORD ~~( )~~ I SET A  $\frac{5}{8}'' \times 30\frac{1}{2}''$  IRON ROD AT NNW COR DLC 43.

SEE ATTACHED PHOTOSTATIC COPY WITH MY ADDITIONS IN RED.

3-3-77

*Larry L. Monrean*

L. E. MONREAN

C. S. File No. 59/31

*LM*

Cors Referenced out


For Rd Work

SW PLC # 14

NW PLC # 13

T27S R7W-

Cors Referenced as follows

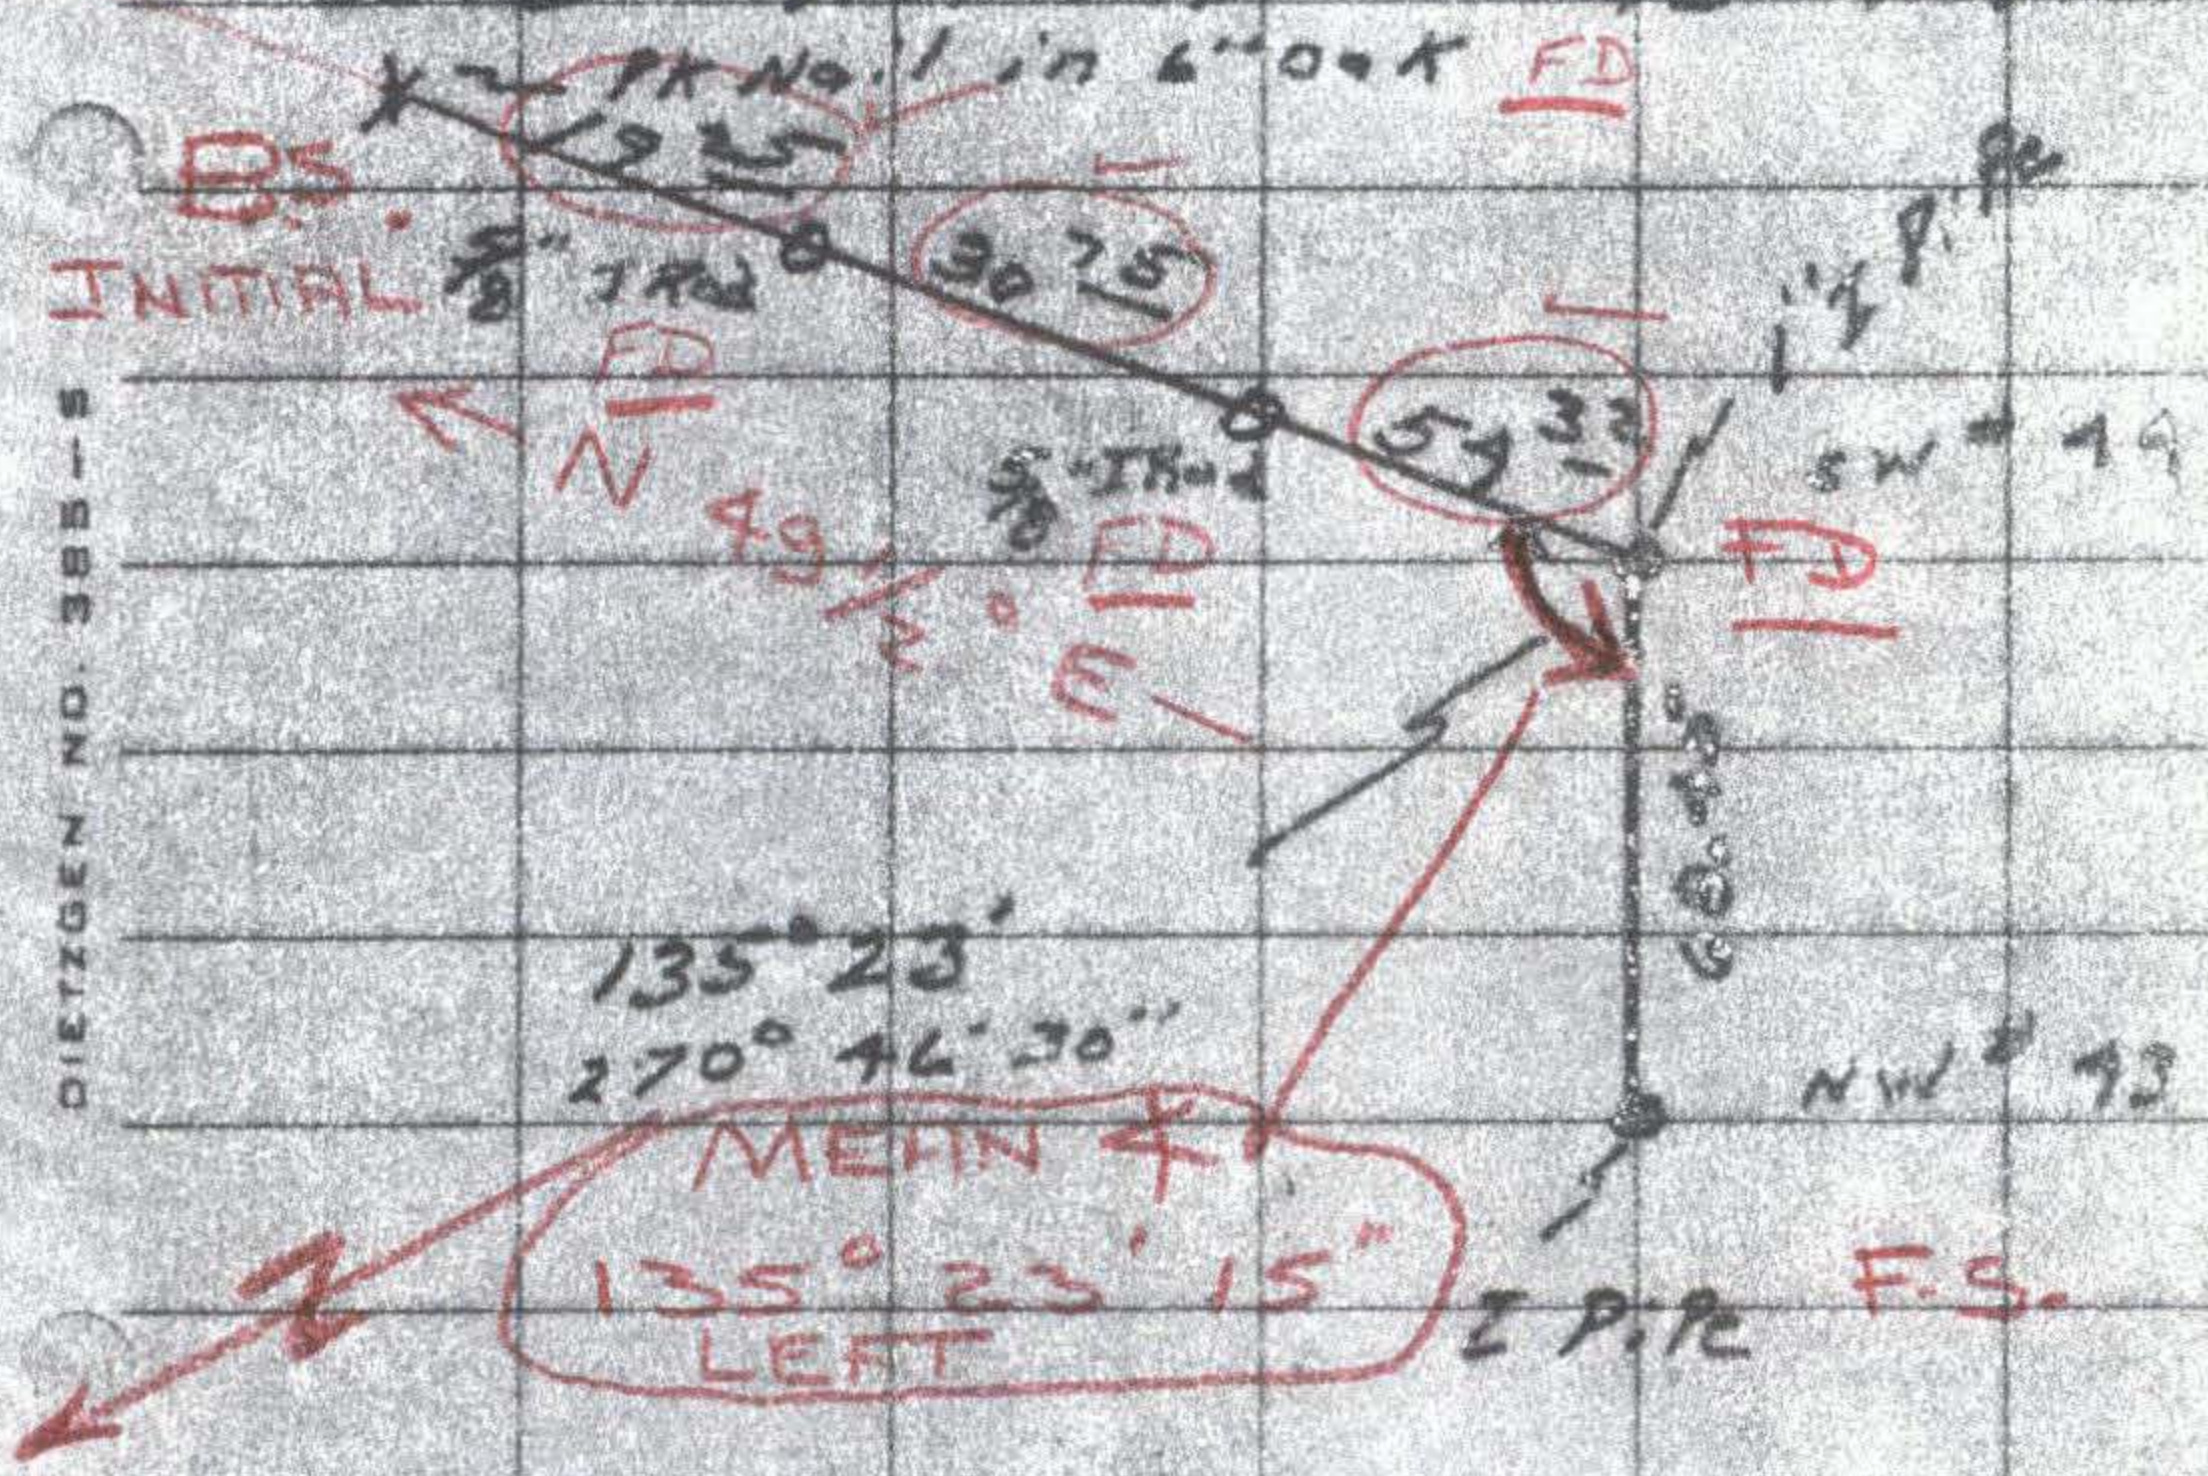

DIETZEN NO. 385-5

SET 5/8" x 30 1/2" I.R.

DEM 5-30-73

J.M.P.

J.J.J.

CS 59/31-5

G.S. File No. 59/30

Ref. 2/21