

DATE: 3-3-77

T 27 S R 7 W

SW  
DLC 44

IN SECTION 2

Condition Report Only  
Not Found  
 Renewed  
Unrecorded  
Surveyed In  
Referenced Out

Previous Renewal #'s 21, 72, & CS FILE 45/86

Monument(s) Found: (Condition and Source) 1 INCH DIAMETER

IRON PIPE 6 INCHES BELOW SURFACE

OF GRAVELED ROAD. (PIPE SET PER CS  
45/86)

Accessories Found: (Condition and Source)

1. STUMP HOLE OF ORIGINAL 24 INCH  
DIAMETER OAK BEARS N 80° E 159<sup>+</sup> FEET

2. A 14 INCH R. FIR NOW A STUMP BEARS N 44<sup>1</sup>/<sub>2</sub>° E  
27<sup>9</sup> FEET TO FACE. BOTTOM OF HEALED

BLAZE REMAINS ON LOW CUT STUMP.  
(REN. NO. 72)

#184 ✓

NO OTHER B.T.S FOUND

RENEWAL

Monument Set: (Procedure and Description) I DO NOT

SET NEW MONUMENT.

New Accessories: (Description)

1. ON A BEARING OF  $N 49^{\frac{1}{2}}^{\circ} E$  ~~THE~~ A  $\frac{5}{8}$  INCH IRON

ROD  $54^{\frac{32}$  FEET, A  $\frac{5}{8}$  INCH IRON ROD  $85^{\frac{07}$ , AND A P.K.

NAIL IN A 6 INCH DIAMETER OAK ~~AT~~  $104^{\frac{32}$  FEET.

(SET BY POWELL  
1973 REF.)

2. A D. FIR 10 INCH DIAMETER BEARS  $N 69^{\circ} E$   $100^{\frac{1}{2}}$  FEET.

TREE DOUBLE BLAZED AND SCRIBED "SWCL44CSBT".

Location and Comments:

$20^{\circ} E$

D.C. S.O.

LARRY E. MONKEAN

*Larry Monkean*

STEVE FLAUSE

Compass Declination

Agency

Party Chief

Notekeeper

Witnesses

*[Handwritten signature]*

CORS Referenced out

For Rd Work


SW DLC # 14

NW DLC # 43

T27S R7W.

CORS Referenced as follows:

X = PK No. 1 in 6" oak

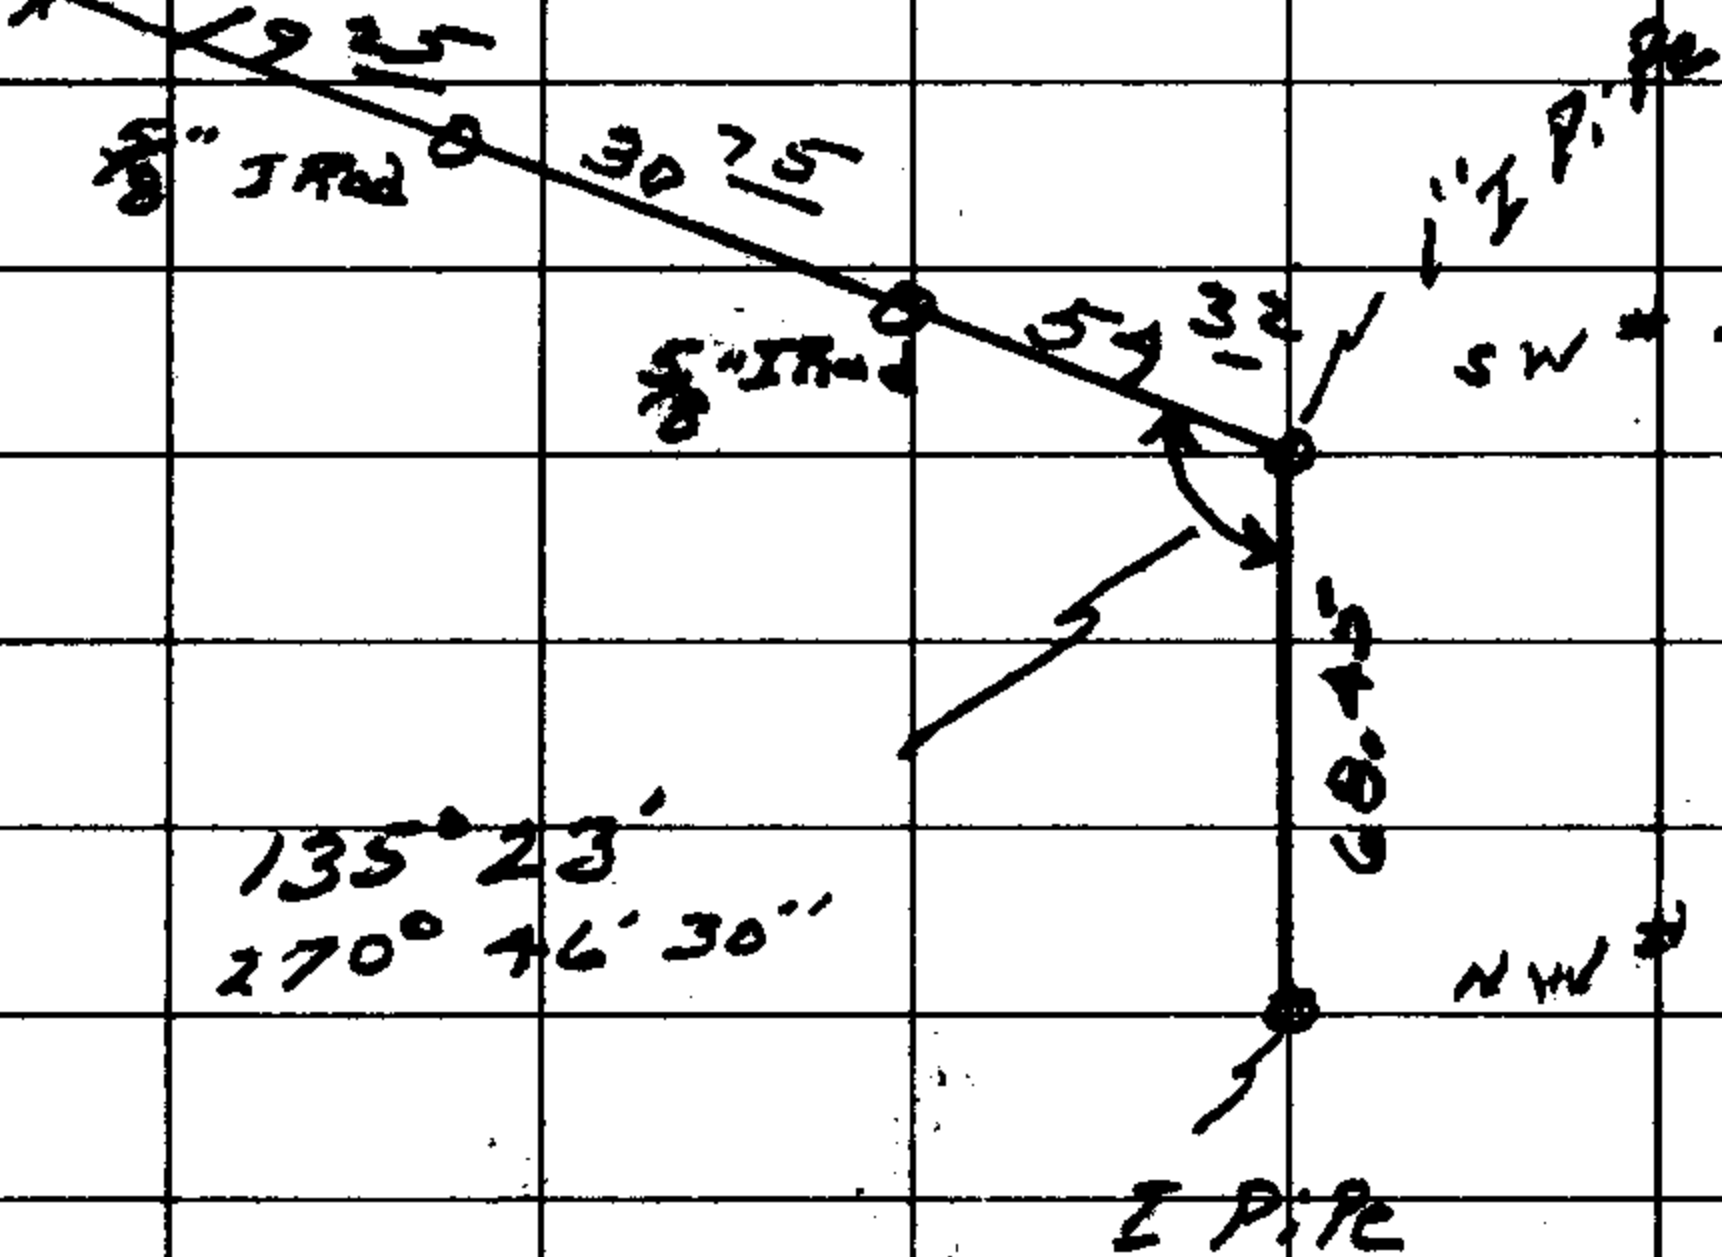

DIETZGEN NO. 388-5

5-30-73

J. J. J.

J. J. J.

C.S.

~~C.S. File No. 59/30~~

REF. NOTED.

7/24