


T295 RBW

DATE: 5-9-77

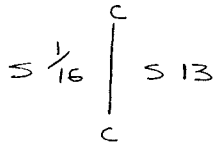

 Condition Report Only

 Not Found

 x Renewed

 Unrecorded


 Surveyed In

 Referenced Out

Previous Renewal #'s SEE CS 58/82 FOR UNOFFICIAL 1975 SURVEY NOTES

Monument(s) Found: (Condition and Source) A 2 1/2" IRON PIPE, FIRMLY SET,

EXTENDING 8" ABOVE GROUND, WITH STANDARD BLM BRASS CAP ATTACHED,

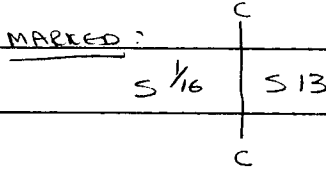

1975

Accessories Found: (Condition and Source) FROM UNOFFICIAL 1975 SURVEY

A 10" NOW 10" D. FIR, WITH SCRIBING "CS 1/16 S 13 BT" VISIBLE ON UNHEALED
SINGLE BLAZE BEARS S 78°W 32 3/4 FT. (REC. PER CS 58/82 S 80°W 32 3/4 FT.)

AND A 12" NOW 13" D. FIR, WITH SCRIBING "CS 1/16 S 13 BT" VISIBLE ON
UNHEALED SINGLE BLAZE BEARS N 17°E 23 1/2 FT. (REC. PER CS 58/82
N 15°E 23 1/2 FT.)

#171 ✓

C

RENEWAL

Monument Set: (Procedure and Description) NONE

New Accessories: (Description) NONE

Location and Comments:

20° EAST
DOUGLAS G. SURVEYOR
GARY L. LANGLITZ
Gary L. Langlitz
PETER L. EARLE
STEPHEN J. FLAUSE

Compass Declination
Agency
Party Chief
Notekeeper
Witnesses

OK
[Signature]