

T285

DATE: 7-6-77

C  
CN 1/16 | 56  
C  
RTW

Condition Report Only  
 Not Found  
 Renewed  
 Unrecorded  
 Surveyed In  
 Referenced Out

Previous Renewal #'s NONE M13-19

Monument(s) Found: (Condition and Source) NONE

Accessories Found: (Condition and Source) A 15 INS. NOW 16 INS.  
DIA. MADRONE WITH PARTIALLY HEALED DOUBLE BLAZE  
AND SCRIBE MARKS VISIBLE BEARS S54 S25°W 54° FT.

TREE IS NOW DOWN

#236 ✓

U.S. File No. 59/38-4 Page 1 of 1


C

RENEWAL

Monument Set: (Procedure and Description) SET 1" x 36" I.P. WITH

BRASS CAP 8 INS ABOVE GROUND MARKED

" COUNTY SURVEYORS OFFICE  
T285

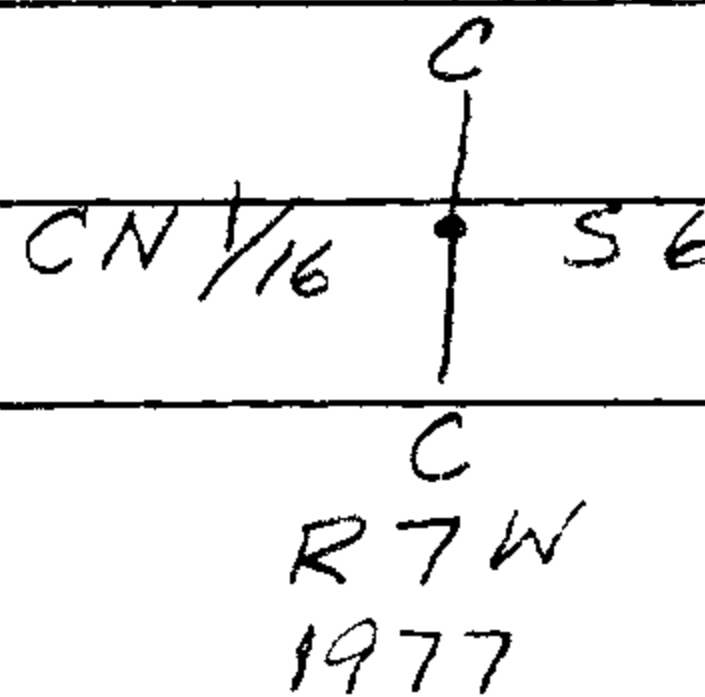

New Accessories: (Description)

A 5 INS. DIA. D. FIR BEARS S 58 1/2° E 41° FT., DOUBLE  
BLAZED AND SCRIBED CN 1/16 S6 CS BT

A 13 INS. DIA. MADRONE BEARS S 84 1/2° W 108 1/2 FT., DOUBLE  
BLAZED AND SCRIBED CN 1/16 S6 CS BT

Location and Comments:

<u>20° E</u>	Compass Declination
<u>DC50</u>	Agency
<u>R.B. KIMBERLING</u>	Party Chief
<u>R.B. Kimberling</u>	Notekeeper
<u>M.W. CLINE</u>	Witnesses

OK  
*[Signature]*