

DATE: AUG. 17, 1977

T325 R6W

S26 | S25
1/4 COR

Condition Report Only
Not Found
 Renewed
Unrecorded
Surveyed In
Referenced Out

Previous Renewal #'s 42

Monument(s) Found: (Condition and Source) A 1 INS. IRON PIPE SET

10 INS. ABOVE GROUND WITH BRASS CAP FACING EAST

"COUNTY SURVEYORS OFFICE"

1/4 COR

25

25

T325 R6W

LS 5

Accessories Found: (Condition and Source) A B. OAK, 15 INS. NDW

19 INS. DIA., BEARS S31°W 13 3/4 FT. WITH PARTIALLY HEALED,

ROTTED OUT SINGLE BLAZE. A B. OAK, 22 INS. DIA. BEARS

S60°W 40 3/4 FT (REC. S57°33'W 39 3/4 FT.) WITH PARTIALLY

HEALED ROTTED OUT SINGLE BLAZE. A 26 INS. ^{DIA.} DEAD INCENSE

CEDAR BEARS N23°30'W 23 1/2 FT. WITH PARTIALLY HEALED

DOUBLE BLAZE AND ^{VISIBLE} SCRIBING "1/4 S CS BT"

#147 ✓

C. S. File No. 59/38-17

Page 1 of 1

C

RENEWAL

Monument Set: (Procedure and Description) NONE

New Accessories: (Description) A D. FIR, 9 INS. DIA., BEARS

N 70 1/2° E 12 1/2 FT., DOUBLE BLAZED AND MARKED "1/4 S 25
T 325 R 6 W C 5 BT"

Location and Comments:

FROM B.C. FENCE
RUNS WEST
N-S FENCE IS 12 FT
WEST OF B.C.

20° E

Compass Declination

DC 50

Agency

R. B. KIMBERLING


Party Chief

R B Kimberling

Notekeeper

M. W. CLINE

Witnesses

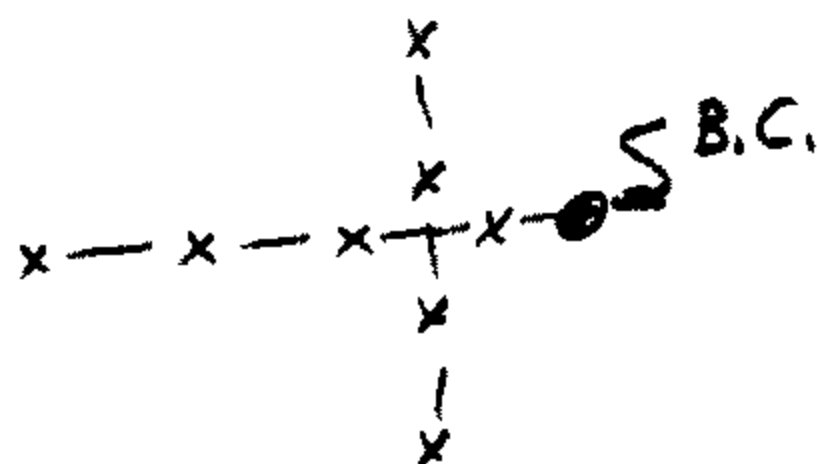

OK
[Signature]