

DATE: 9-20-77

T 21 S R 11 W

N 1/2 } S 4
 c
 c

Condition Report Only

Not Found

Renewed

Unrecorded

Surveyed In

Referenced Out

Previous Renewal #'s NONE

Monument(s) Found: (Condition and Source) NONE

Accessories Found: (Condition and Source) NONE


104 ✓

lee

Page 1 of 1
G. S. File No. 59/40-20 C

RENEWAL

Monument Set: (Procedure and Description) SET 1 INCH BY 30 INCH IRON
PIPE WITH BRASS CAP ATTACHED AT CORNER POINT AS DETERMINED
BY SINGLE PROPORTION. CAP IS 3 INCHES ABOVE GROUND MARKED
" DOUGLAS COUNTY SURVEYOR "
TRIS RIW

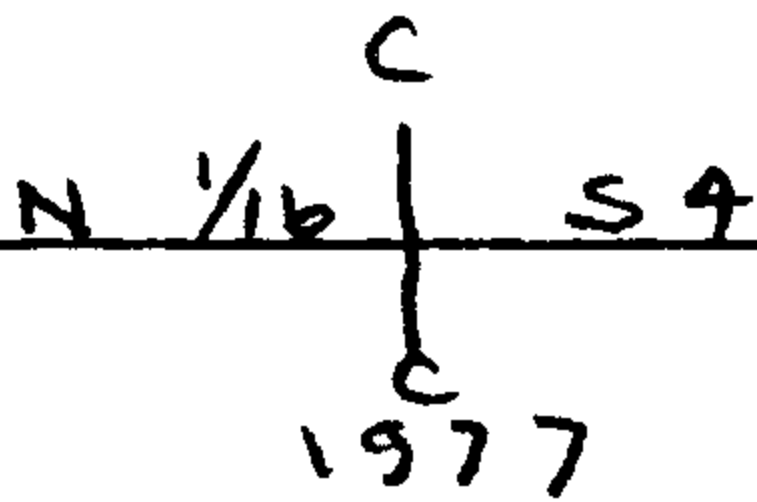

New Accessories: (Description) 1) A D. FIR 20 INCH DIAMETER
BEARS N 58 1/2° W 4 1/4 FEET. TREE DOUBLE BLAZED AND
KNIFE SCRIBED " CN 1/16 S 4 CS BT", 2). A CEDAR 9 INCH
DIAMETER BEARS S 9 1/2° W 10 1/4 FEET. TREE DOUBLE
BLAZED AND KNIFE SCRIBED " CN 1/16 S 4 CS BT".

Location and Comments:

20° EAST
DCSD
LARRY E. MONREAN
Larry E. Monrean
P. L. EARLE

Compass Declination
Agency
Party Chief
Notekeeper
Witnesses

2° 24' 17"

APPROX

CN 1/16 S 4

789 407.747

1071945.354

+ 12.794

+ 0.234

CN 1/16 S 4

789 420.541

11071945.588

2° 24' 17" 2.35

N 2° 2' 52" E

N 1° 21' 25" W 12.80±7