

DATE: 10-27-77

		T315	
R	S12		S7 R
4	S13		S18 3
W			W

- Condition Report Only
- Not Found
- Renewed
- Unrecorded
- Surveyed In
- Referenced Out

Previous Renewal #'s #79 T31-4

Monument(s) Found: (Condition and Source) NONE

Accessories Found: (Condition and Source) A FIR STUMP, 45" NOW 38"

DIA. (BARKED) BEARS N26 1/2° E 47 1/2 FT. WITH WELL HEALED BLAZE

(O.B.T.), A FIR STUMP, 28" NOW 30" DIA. BEARS S8° E 85 1/2 FT. (REC

89 1/2 FT., POSSIBLE O.B.T.). ~~CORNER~~ <sup>#1</sup> ~~WAS~~ <sup>CORNER</sup> RESET FROM REFERENCES

SET 4-19-74 BY G. LANGLITZ, SEE ATTACHED NOTES.

REFERENCES INTERSECT WITHIN 0 07 FT.

#201 T31-3 ✓  
#165 T31-4 ✓

C

RENEWAL

Monument Set: (Procedure and Description) A 5/8" x 30" IRON ROD  
WITH 1 1/2" DIA. ALUM. CAP SET 9" BELOW GROUND, MARKED  
SET A 3/4" x 30" BENT IRON PIPE 21" IN  
GROUND AT EDGE OF ALUM. CAP, IN A  
24" DIA. MOUND OF STONE TO TOP OF I.P.

"DOUGLAS CO."  
T315  
R 12 7 R  
4 13 18 3  
W W  
SURVEYOR

New Accessories: (Description) A 30" DIA. INCENSE CEDAR  
(USED TO REFERANCE CORNER IN 1974) BEARS N 73 3/4° W 200 ± FT.,  
DOUBLE BLAZED AND SCRIBED "T315 R4W S12 CS BT",  
A 12" DIA. DOUGLAS FIR BEARS N 87° E 92 ± FT., DOUBLE  
BLAZED AND SCRIBED "T315 R3W S7 CS BT". A 5/8" x 30" IRON  
ROD WITH 1 1/2" DIA. ALUM. CAP SET 9" ABOVE GROUND, MARKED  
BEARS N 35 1/4° W 108 ± FT. (USED TO REFERANCE CORNER IN 1974)

"DOUGLAS CO."  
B. O.  
SURVEYOR

Location and Comments:  
CORNER LIES AT END  
OF ROAD #31-4-13  
IN LANDING OF A  
CLEARCUT UNIT.

20° E  
DCSO  
R. B. KIMBERLING  
R. B. Kimberling  
M. W. CLINE

Compass Declination  
Agency  
Party Chief  
Notekeeper  
Witnesses

OK  
*[Signature]*

T315

4-19-74

R4W

12	7
13	18

R3W

RENEWAL # 79

THIS CORNER HAS BEEN REFERENCED OUT AT THE REQUEST OF THE B.L.M.

FD:

$\frac{3}{4}$ " IRON PIPE AND REMAINS OF A STONE - ALL BEARING TREES, BOTH ORIGINAL AND THOSE MARKED IN 1959 WERE VERIFIED WITH THE FOLLOWING EXCEPTIONS:

THE ORIGINAL SE BEARING TREE A 36" FIR S80°E 90.0 FT. COULD NOT BE POSITIVELY IDENTIFIED.

THE 15" FIR S70°E 7° FT, MARKED IN 1959 HAS BROKEN <sup>OFF</sup> AT GROUND LEVEL.

I REMOVE THE IRON PIPE AND REFERENCE THE LOCATION AS FOLLOWS:

REF. NOTED.  
V. STATES

CS FILE NO. 57/22  
CS FILE NO. 59/22

PAGE 1

OBT SW

74<sup>8</sup> @ 6°24' .99377

74<sup>3</sup>

S 31°W OK RECORDED

LAUREL SW

30<sup>4</sup> @ 19°09' .94466

28<sup>7</sup>

OBT FIR SE

93<sup>8</sup> @

89<sup>7</sup> @ 26°12' .89726

80.5

FIR SE

7<sup>0</sup> LVL

FIR NE

15<sup>8</sup> @ 25°32' .90233

14<sup>3</sup>

OBT NE

48<sup>5</sup> @ 9°54' .98511

47.8

CEDAR NE


22<sup>6</sup> @ 7°26' .99160

22<sup>4</sup>

OBT NW

50<sup>8</sup> @ 26°56' .89153

45<sup>3</sup>

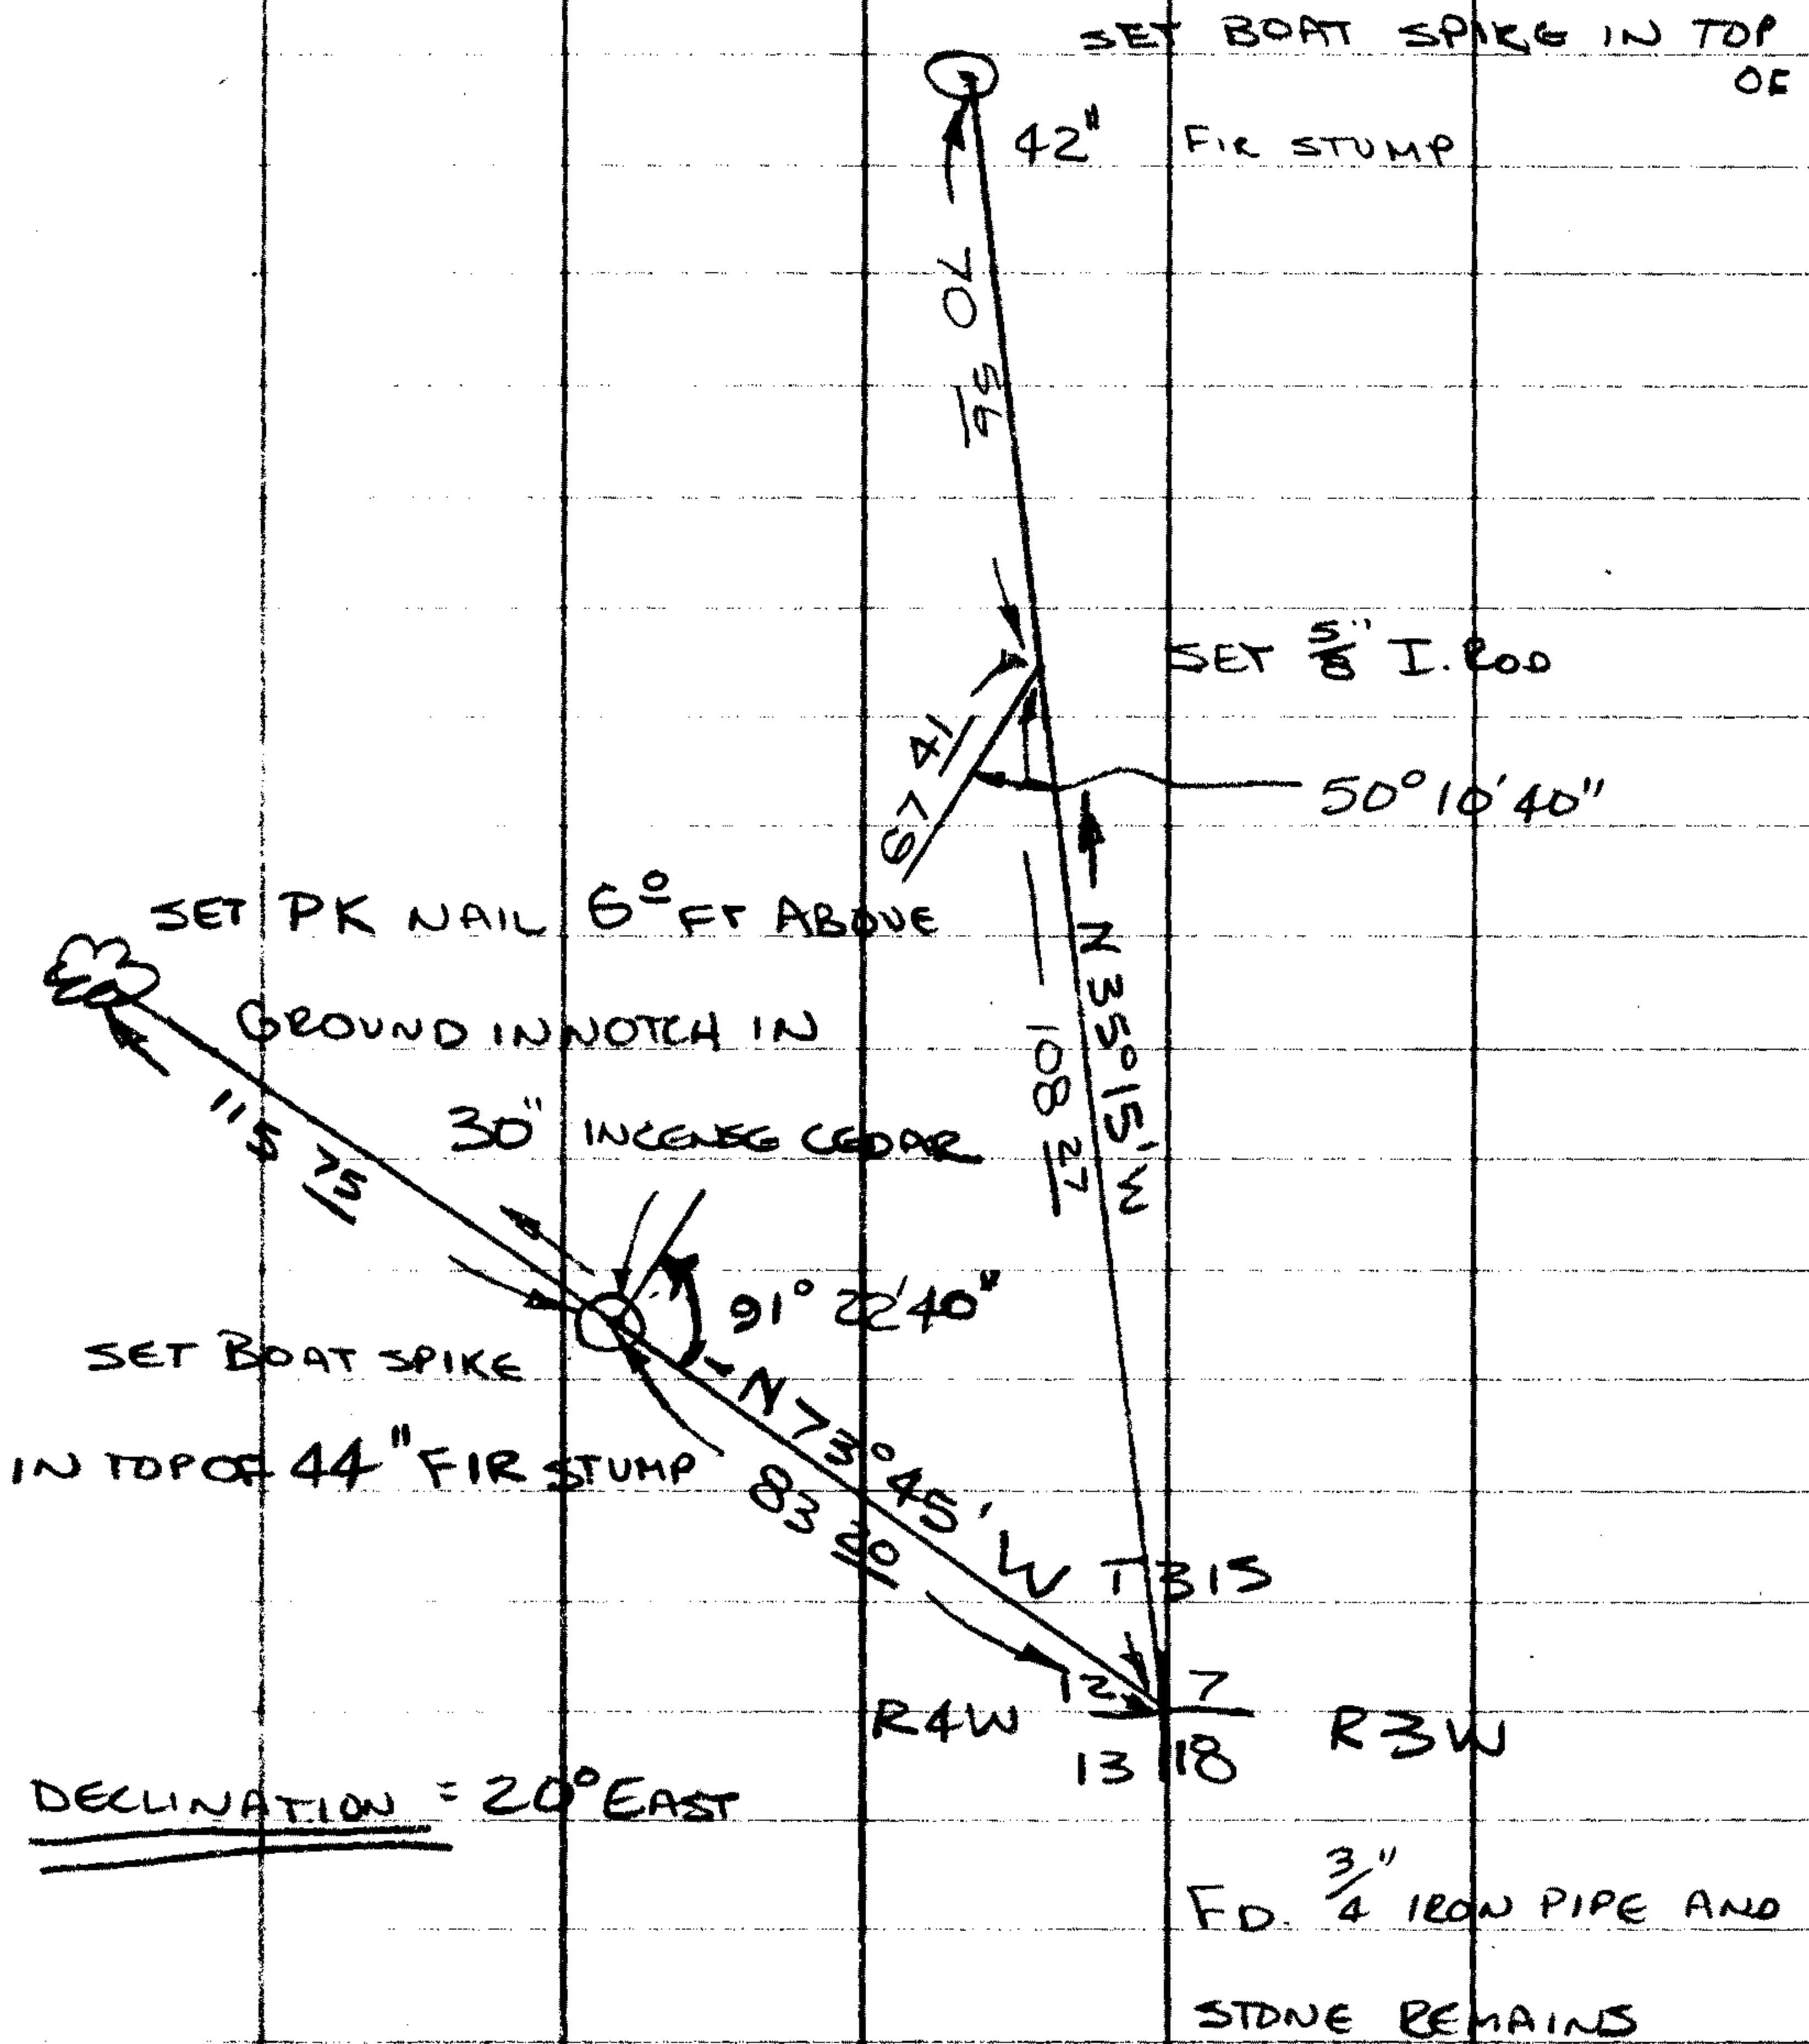

4-19-74

Gary Langley  
BOB THURMAN

~~C. S. File No. 59/30~~

OK  
C. S. File No. 59/40-57