

Continuation Sheet

T295 RIW

528 | 527

533 | 334

DATE: 3-22-78

- Condition Report Only
- Not Found
- Renewed
- Unrecorded
- Surveyed In
- Referenced Out

Previous Renewal #'s _____

Monument(s) Found: (Condition and Source) _____

Accessories Found: (Condition and Source) ALSO FOUND
WAS A LOCATION SIGN (U.S.F.S.) NAILED
TO THE NEW B.T. (YEW) TO THE SE.
THIS SIGN READS "MM 2-5-48"
"O CH. ^{BLANK} OF SEC COR"
ORIGINAL B.T. TO THE NE IS GONE.

Q FRANCIS CRK TO THE NORTH IS 64'

RECORD IS 66'

Q FRANCIS CRK. TO THE EAST IS 48'

RECORD IS 49.5'

TOP OF BLUFF TO WEST IS 67' HORIZ &

99' SLOPE DIST. RECORD IS 99'

RENEWAL

Monument Set: (Procedure and Description)

I DISCOUNT THE MAPLE B.T. AS

IT DOES NOT FIT RECORD BEARING

& DISTANCE. IT MAY HAVE BEEN ORIGINALLY

SLOPE CHAINED. SEE CS FILE

54/82 FOR MORE INFORMATION ON THIS CORNER.

New Accessories: (Description) A BOULDER, 35'x35'x

30' HIGH ON EAST EDGE OF FRANCIS CRK

BEARS N 56°E, 67.0'

A 8" DOUG FIR BEARS ~~N 88°~~ N 87°W, 23.4'

SCRIBED "T295 RIW S28 CS BT" ON A DOUBLE

BLAZE. A 15" YEW BEARS S 41°W, 68.6'

SCRIBED "T295 RIW S33 CS BT" ON A DOUBLE BLAZE

Location and Comments:

Compass Declination

I PLACED COUNTY

Agency

B.T. SIGNS ON

Party Chief

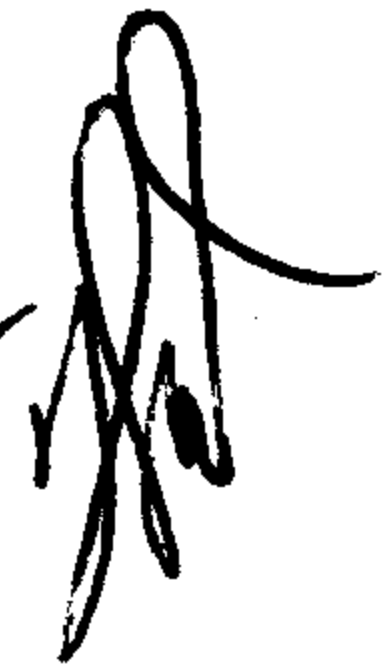
THE THREE ORIGINAL

Notekeeper

B.T.'S & THE FOUR

Witnesses

NEW B.T.'S

OK 

DATE: 3-22-78

SURVEYOR'S
T 295 R/W
COUNTY OFFICE

- Condition Report Only
- Not Found
- Renewed
- Unrecorded
- Surveyed In
- Referenced Out

528	527
533	534

1978

Previous Renewal #'s SEE C.S. 54/82 ^(NF Info) (COPY ATTACHED)

Monument Found: (Condition and Source) ORIGINAL CORNER

STONE FOUND OUT OF PLACE. STONE HAS ONE NOTCH ON WHAT WAS SOUTH ^{EDGE} SIDE, 3 NOTCHES ON WHAT WAS EAST EDGE, AND "X" ON TOP.

CORNER STONE APPEARS TO HAVE BEEN KNOCKED LOOSE BY FALLING ROCKS, AS CORNER POINT FALLS IN A STEEP TALUS SLOPE. CORNER STONE SLID APPROX. 5 ~~10~~ FEET DOWN SLOPE.

STONE IS 15" x 8" x 4"

Accessories Found: (Condition and Source) A 12" VEW BEARS

S 59° E, 28.38'. PREVIOUSLY OPENED & NOW DOWN. NO SCRIBING FOUND. A U.S.F.S.

LOCATION SIGN IS ATTACHED & READS "1-23-4) H.H. LOCATED BY COMPASS & CHAINING"

THIS SIGN APPARENTLY SET BY HOWARD HASKELL, WHO DID EXTENSIVE CORNER SEARCH IN

#1234

C

THIS TSWP. IN THE SPRING OF 1941. (U.S.F.S. EMPLOYEE)

A 26" ALDER BEARS N 19° W, 70.62'. PREVIOUSLY OPENED. NO SCRIBING VISIBLE.

A 10" MAPLE BEARS S 11° W, 45.1' (RECORD 58° W, 50.16') PREVIOUSLY OPENED & NOW DOWN. NO SCRIBING. THIS B.T. IS ON A SLOPE 70% ABOVE CORNER. RENEWAL

Monument Set: (Procedure and Description) USING THE ORIGINAL YEW & ALDER BEARING TREES FOR REFERENCE, AT THE CORNER POINT I SET A 2 1/2" BRASS CAP ON A 1" I.P. BRASS CAP STAMPED AS SHOWN ON REVERSE. I BURY CORNER STONE ON EAST SIDE OF BRASS CAP (SEE SHEET 2)

New Accessories: (Description)

A 8" YEW BEARS S 72° E, 26.7' SCRIBED "T29S RIWS34 CSBT" ON A DOUBLE BLAZE.

A 24" SUGAR PINE BEARS N 40° E, 117.5' SCRIBED "T29S RIW 527 CSBT" ON A DOUBLE BLAZE.

THIS B.T. IS ACROSS FRANCIS CREEK, (SEE SHEET 2)

Location and Comments:	<u>18° E</u>	Compass Declination
	<u>U.S.F.S.</u>	Agency
	<u>DENNIS GAYLORD</u>	Party Chief
	<u>" "</u>	Notekeeper
	<u>ROLAND SIMSHAUSER</u>	Witnesses
	<u>_____</u>	
	<u>_____</u>	

Not Found

EBR7
33/34

Found:

Possible:

Maple - Bearing + Dist

Yew - Bearing + Dist

Alder - Bearing + Dist

Maple old face on outside of
tree: Batted out.

Yew - No evidence

Alder - old faces No evidence

1998 Forest location tree

good approx Dist to creek
for call of 1 chard.

However not convinced this is
cor.

7/11/92

C.H.
J.P.

~~5/1/92~~

C.S. 59/96

COPY FROM

Boxwood
Found
36" dia

70'

56'

T 29 S R 1 W

28 | 27
33 | 34

SKETCH SHOWING RELATIONSHIP OF ORIGINAL G.L.O. CALLS.

