

T295

DATE: 4-5-78

535	536	R
52	51	7
T305		W

Condition Report Only
 Not Found
 Renewed
 Unrecorded
 Surveyed In
 Referenced Out

Previous Renewal #'s #23 T30-7 # 82 T29-7

Monument(s) Found: (Condition and Source) A 3/4" DIA. IRON PIPE, 12"
ABOVE GROUND, BEARS S58°W 2° FT. FROM CORNER, WITH A 3" x 3"
SQUARED POST AT THE WEST SIDE (REN #23)

Accessories Found: (Condition and Source) (O.B.T.) A 24" DIA. MADRONE
(LAUREL) BEARS S68°E 27¹/₂ FT. WITH AN OPENED BLAZE AND VISABLE
SCRIBING "S-T30SR7". (REN #23) A 18" ^{DIA.} NOW 24" MADRONE (LA.) BEARS
S83 1/2° W 35¹/₂ FT. (REG. S86°W 34° FT.) WITH VISABLE SCRIBING "S2T30SR7"
IN A DOUBLE PARTLY HEALED BLAZE. A 30" NOW 31" DIA. MADRONE
(LA.) BEARS N21°W 35° FT. WITH VISABLE SCRIBING "3-29" IN A
DOUBLE PARTLY HEALED BLAZE. A 15" NOW 18" MADRONE (LA.) BEARS N39°E

#120 T30-7 ✓
 #258 T29-7 ✓

34° FT. (REC. 36° FT.) WITH VISABLE SCRIBING "3-29-R7-BT" IN A
 DOUBLE PARTLY HEALED BLAZE. A 35" NOW 39" DIA. MADRONE (LA.)
 BEARS S20½° E (REC. S24° E) 45° FT. WITH VISABLE SCRIBING
 "S1T305R7WM" IN A DOUBLE PARTLY HEALED BLAZE.

NOTE: SCRIBING IS CUT HORIZONTAL IN ALL BLAZES.

RENEWAL

Monument Set: (Procedure and Description) A 1" x 36" IRON PIPE
WITH BRASS CAP SET 6" ABOVE GROUND AND MARKED
"DOUGLAS COUNTY SURVEYOR"

T295
 R S35 | S36
 7 S2 | S1
 W T305
 1978

~~T295~~
~~S35 | S36~~
~~S2 | S1~~
~~T305~~

New Accessories: (Description) NONE

Location and Comments:	<u>20° E</u>	Compass Declination
CORNER IS AT THE N.W.	<u>DCSD</u>	Agency
CORNER OF AN OLD GROWTH	<u>R.B. KIMBERLING</u>	Party Chief
W TIMBER	<u>R.B. Kimberling</u>	Notekeeper
	<u>P.L. EARLE</u>	Witnesses

OK
[Signature]

T305 R7W

DATE: 4-4-78

S2	S1
S11	S12

Condition Report Only
 Not Found
 Renewed
 Unrecorded
 Surveyed In
 Referenced Out

Previous Renewal #'s #25

Monument(s) Found: (Condition and Source) A 1 1/2" x 35" AXLE WITH 5" FLANGE DOWN, SPLINE END 15" ABOVE GROUND.

Accessories Found: (Condition and Source) A 52" DIA. P. PINE BEARS S70°E 63 1/2 FT WITH VISABLE SCRIBING "S2" IN A CHOPPED OPEN BLAZE. THE EAST FORK OF A I. CEDAR IS (12") NOW 16" DIA. AND A 12" NOW 16" DIA. I. CEDAR BEARS N20°W 5 1/2 FT. WITH SCRIBING "S2 BT" IN A PARTLY HEALED DOUBLE BLAZE. A 12" NOW 16" DIA. I. CEDAR BEARS N80°W 7 1/2 FT. WITH A PARTLY HEALED DOUBLE BLAZE. A 5" NOW 8" DIA. W. OAK BEARS N74°E (REC. N72°E) WITH A 34° FT. WELL HEALED DOUBLE BLAZE. A 12" NOW 13" DIA. I. CEDAR BEARS

119 X

C

S 52° E 11⁸ FT. WITH VISABLE SCRIBING "S 12 BT" IN A PARTLY HEALED DOUBLE BLAZE. SCRIBING IS WRITTEN UP THE TREES.

RENEWAL

Monument Set: (Procedure and Description) SET A 1" x 36" IRON PIPE WITH A BRASS CAP 6" ABOVE GROUND AT AXLE LOCATION, MARKED "COUNTY SURVEYOR" T305 R7W . I SET AXLE S.W. 0³ FEET FROM THE BRASS CAP, 1⁰ FT. ABOVE GROUND.

S 2 | S 1
S 11 | S 12
1978
DOUGLAS

WITH THE SPLINE END

New Accessories: (Description) A 12" DIA. I. CEDAR BEARS S 52° W 11⁷ FT. DOUBLE BLAZE AND SCRIBE "T 305 R 7 W S 11 CS BT".

Location and Comments:
REMAINS OF A FENCE (N.E.-S.W.) ARE AT THE N.W. BEARING TREE. A BLM ROAD IS SOUTH 53⁰ FEET.

<u>20° E</u>	Compass Declination
<u>DC50</u>	Agency
<u>R. B. KIMBERLING</u>	Party Chief
<u>R B Kimberling</u>	Notekeeper
<u>P. L. EARLE</u>	Witnesses
<u>F. G. SILAGY</u>	

OK *[Signature]*


H
23
82
120

P-9180-4
Jan. 1965

LOCAL RECORD
CORNERS OF THE CADASTRAL SURVEY GRID

UNITED STATES
DEPARTMENT OF THE INTERIOR
BUREAU OF LAND MANAGEMENT

T. 30 R. 7, WM Mer., OR State.

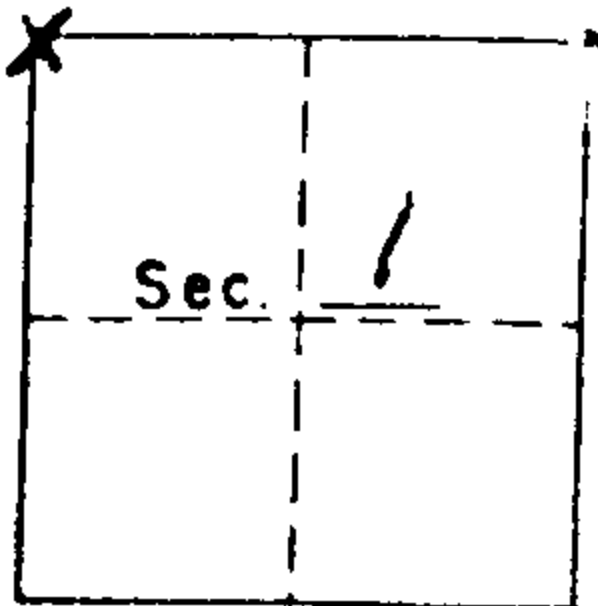

SYMBOLS

Registered

◆ Official corner found

◇ Probable corner found, authenticity doubtful.

○ Corner searched for and not found.

Reported By Jesse McLaughlin

Title Forester

Date 11-16-76

MARKS:

Corner common to Secs. 1, 2, 35 & 36 is a mound of stone, tree, rock, fire pit, iron pipe size _____

LEGIBLE MARKS ON BEARING OBJECTS

KIND	Laurel	Laurel	Laurel	Laurel
SIZE	40"	20"	36"	24"
BEARING	N24W	S39W	S21E	N56E
DISTANCE	45'	36'	35'	34'
BT TAG POSTED	yes	yes	yes	yes

ADDITIONAL INFORMATION

INTERIOR--BORNEVILLE POWER ADMINISTRATION, PORTLAND, OREGON

(OVER)


59/A6

P-9180-4
Jan. 1965

LOCAL RECORD
CORNERS OF THE CADASTRAL SURVEY GRID

UNITED STATES
DEPARTMENT OF THE INTERIOR
BUREAU OF LAND MANAGEMENT

T. 30 R. 7, WM Mer., _____ State.

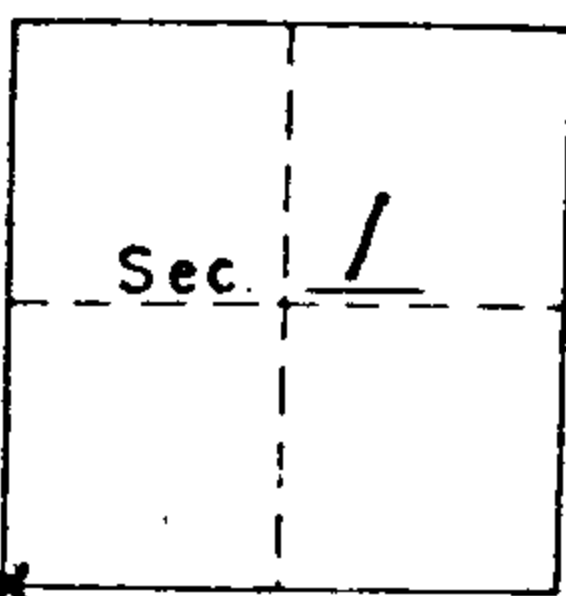

SYMBOLS

Registered

◆ Official corner found

◇ Probable corner found, authenticity doubtful.

○ Corner searched for and not found.

Reported By Jesse McLaughlin

Title Forester

Date 11-16-76

MARKS:

SEC Corner common to Secs. 1, 2, 11 & 12 is a mound of stone, tree, rock, fire pit, iron pipe, AXLE size _____

LEGIBLE MARKS ON BEARING OBJECTS

KIND	PP	IC		
SIZE	40"	12"		
BEARING	N65W	S10E		
DISTANCE	60'	4'		
BT TAG POSTED	NO	NO		

ADDITIONAL INFORMATION

INTERIOR--BORNEVILLE POWER ADMINISTRATION, PORTLAND, OREGON

(OVER)

#119
#25

C. S. File No. 59/A6-46