


H  
23  
82  
120

P-9180-4  
Jan. 1965

LOCAL RECORD  
CORNERS OF THE CADASTRAL SURVEY GRID

UNITED STATES  
DEPARTMENT OF THE INTERIOR  
BUREAU OF LAND MANAGEMENT

T. 30 R. 7, WM Mer., Ore State.

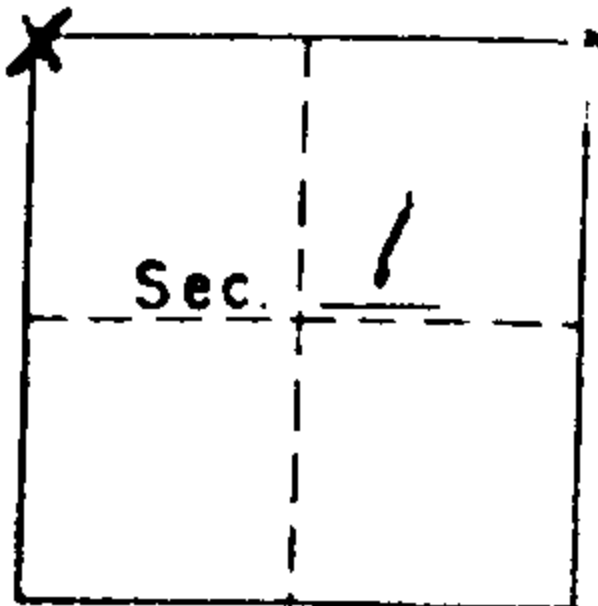

SYMBOLS

Registered

- ◆ Official corner found
- ◇ Probable corner found, authenticity doubtful.
- Corner searched for and not found.

Reported By Jesse McLaughlin  
Signature  
Title Forester  
Date 11-16-76

Corner common to Secs. 1, 2, 35 & 36 is a mound of stone, tree, rock, fire pit, iron pipe size \_\_\_\_\_

LEGIBLE MARKS ON BEARING OBJECTS


KIND	Laurel	Laurel	Laurel	Laurel
SIZE	40"	20"	36"	24"
BEARING	N24W	S39W	S21E	N56E
DISTANCE	45'	36'	35'	34'
BT TAG POSTED	yes	yes	yes	yes

ADDITIONAL INFORMATION

INTERIOR--BORNEVILLE POWER ADMINISTRATION, PORTLAND, OREGON

( OVER )


59/A6

P-9180-4  
Jan. 1965

LOCAL RECORD  
CORNERS OF THE CADASTRAL SURVEY GRID

UNITED STATES  
DEPARTMENT OF THE INTERIOR  
BUREAU OF LAND MANAGEMENT

T. ~~29~~ 30 R. 7, WM Mer., \_\_\_\_\_ State.

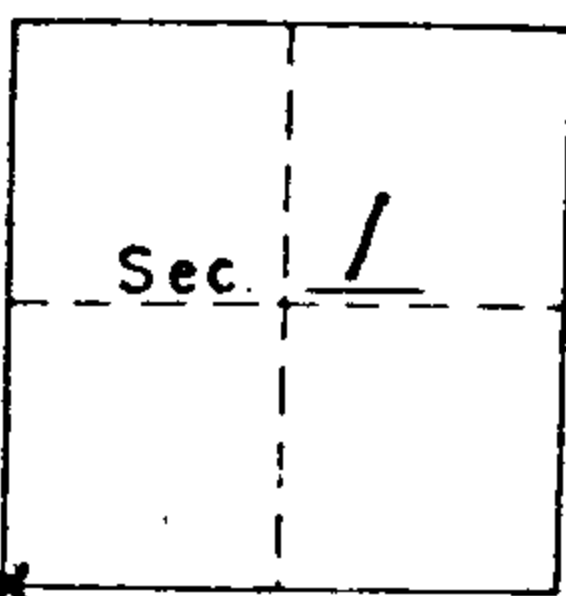

SYMBOLS

Registered

- ◆ Official corner found
- ◇ Probable corner found, authenticity doubtful.
- Corner searched for and not found.

Reported By Jesse McLaughlin  
Signature  
Title Forester  
Date 11-16-76

SEC Corner common to Secs. 1, 2, 11 & 12 is a mound of stone, tree, rock, fire pit, iron pipe, AXLE size \_\_\_\_\_

LEGIBLE MARKS ON BEARING OBJECTS


KIND	PP	IC		
SIZE	40"	12"		
BEARING	N65W	S10E		
DISTANCE	60'	4'		
BT TAG POSTED	NO	NO		

ADDITIONAL INFORMATION

INTERIOR--BORNEVILLE POWER ADMINISTRATION, PORTLAND, OREGON

( OVER )

#119  
#25

C. S. File No. 59/A6-46