

DATE: 3-21-78

T295 R4W
CC 58 / 59
517

Condition Report Only
 Not Found
 Renewed
 Unrecorded
 Surveyed In
 Referenced Out

Previous Renewal #'s #135, #202

Monument(s) Found: (Condition and Source) A 2" DIA. IRON PIPE WITH A
STANDARD BLM BRASS CAP SET 8" ABOVE GROUND, MARKED

"T295 R4W"

CC 58 / 59
517

1969

CADASTRAL SURVEY

Accessories Found: (Condition and Source) (O.B.T.) A 10" NOW 25" DIA.

D. FIR BEARS S33°W 21¹/₂ FT. WITH A WELL HEALED BLAZE. (REN #135)

A 12" NOW 16" DIA. FIR STUMP BEARS N32°E (REG. N30°E) 53³/₄ FT. WITH

SCRIBING "RS9" IN A PARTLY HEALED BLAZE. A 24" DIA. MADRONE

(LAUREL) STUMP BEARS N51°E 104³/₄ FT. (REG. N49°E 106³/₄ FT.)

WITH SCRIBING "9SR" IN PARTLY HEALED BLAZE. A 32" DIA. MADRONE

(LAUREL) STUMP BEARS S38°E 55³/₄ FT. (REG. 61³/₄ FT.) WITH A PARTLY HEALED

#250 ✓

C. S. File No. 59/46-5T Page 1 of 1
C

ROTTED BLAZE. (REN. #202) A 24" DIA. D. FIR BEARS S 16° W 45¹/₂ FT.
(REG. S 15° W 45¹/₂ FT.) WITH A WELL HEALED SINGLE BLAZE.

RENEWAL

Monument Set: (Procedure and Description) NONE

New Accessories: (Description) A 6" DIA. D. FIR BEARS N 5° W 42 FT.
I DOUBLE BLAZE AND SCRIBE "CCT 295 R4W 38 CS BT".

Location and Comments:
CORNER IS 50 FT, EAST
OF RD #29-4-17 IN A
CLEARCUT. BTs ARE ALMOST
THE ONLY TREES STANDING
ON A -36° EAST SLOPE.
A STEEL FENCE POST IS
07 FT. WEST OF CORNER.


20° E
DCSO
R. B. KIMBERLING
R. B. Kimberling
P. L. EARLE
F. C. SILAGY

Compass Declination
Agency
Party Chief
Notekeeper
Witnesses

OK
[Signature]

Cor referenced for Round Point Pl.

T295 RAW $\frac{8}{1719}$ - REN #202

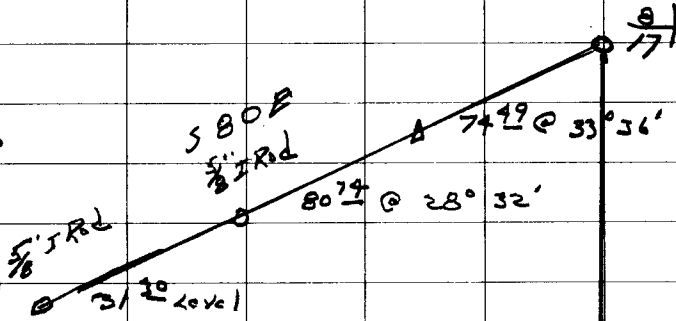

DIETZGEN NO. 385 - 5

FR 1969 B. Gap + Bearing Trees

6-28-73

[Signature]

over

59/46-57

C. S. File No. ~~59/30~~ REF. NOTES 7/21

T295 R4W17¹⁹/₁₆ - GEN No 201

B.C.P



6' 19"
S 22° W

5" 3/8" 3 Rod

4' 2"
1/4"



PK Nail in 8" D. Fir

REF.
NOTE:
J.H