

T225 R6W

DATE: 3-28-78

$\frac{1}{4}$   $\frac{13}{24}$

Condition Report Only  
 Not Found  
 Renewed  
 Unrecorded  
 Surveyed In  
 Referenced Out

Previous Renewal #'s 20, #46, Vol. 3, Page 285

Monument(s) Found: (Condition and Source) NO TRACE OF ORIGINAL POST.  
AT THE CORNER POINT WE FIND THE FOLLOWING:

FD:  $\frac{3}{4}$ " I. PIPE, FLUSH IN THE GROUND, (REN #20)

FD: 1" X 1" - "T"-IRON, EXTENDING 18" ABOVE GROUND ALONGSIDE  $\frac{3}{4}$ " I. PIPE,

WITH COPPER WASHER ATTACHED, MARKED " WILFORD N. HAINES

239

SURVEY POINT

DRAIN, OREGON

Accessories Found: (Condition and Source) NO TRACE OF ORIGINAL

BEARING TREES.

A 20" NOW 40" D FIR, (REN. #20) ALIVE AND IN GOOD CONDITION WITH

WELL-HEALED DOUBLE BLAZE BEARS S 16° E 145<sup>B</sup> FT..

AND A 15" FIR, NOW A 29" STUMP, (REN. #20) WITH WELL-HEALED

DOUBLE BLAZE BEARS N 45° W 93<sup>B</sup> FT, (REC. N 47 $\frac{1}{2}$ ° W 92<sup>B</sup> FT.).

#134X

C

RENEWAL

Monument Set: (Procedure and Description) AT THE CORNER POINT WE SET  
A 1" X 30" I. PIPE, 28" IN THE GROUND, WITH BRASS CAP ATTACHED, MARKED:

WE PLACE FOUND 3/4" I. PIPE AND 1" - "T" - IRON  
ALONGSIDE BRASS CAP.

DOUGLAS CO SURVEYOR  
T 225  
1/4 513  
524  
R G W  
1978


New Accessories: (Description)

A 16" D. FIR, SCRIBED "1/4 S 13 CS BT" ON A DOUBLE BLAZE  
BEARS N 36 1/2° E 22 2/2 FT.

Location and Comments: 20° EAST Compass Declination  
CORNER LOCATED NEAR DOUGLAS CO. SURVEYOR'S OFFICE Agency  
CORNER OF RANDOM FENCES GARY L. LANGLITZ Party Chief  
RUNNING N E, E, AND Gary L. Langlitz Notekeeper  
APPROX. 40 FT WEST OF AN FRANK C. SILAGY Witnesses  
OLD ROAD RUNNING NE-SW,  
AND APPROX. 60 FT. EAST OK  
OF A SMALL DRAW, COURSE  
NE.

Section 13 Twp 22 S Rge 6 W

Date: 12-30-70

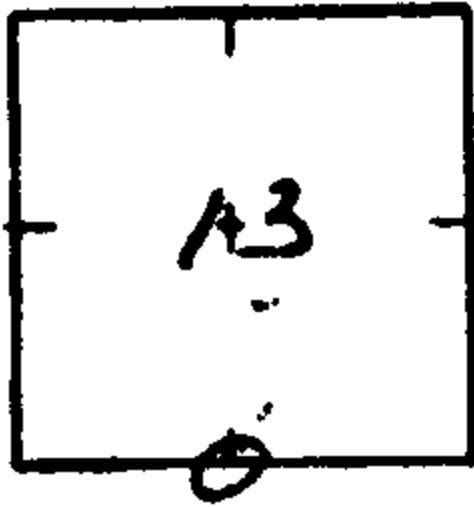

How was corner identified? Haines "T" Iron \* 1" Iron pipe;

2 BT's

Condition of corner: need new BT

Best route to reach corner: S from rd.

Quadrant	NE	NW	SE	SW
Species & Size		28" D stump	40" D	
Dist. & Bearing		S47 1/2 E, 92.8' NW, 145.4'		
Condition of Scribe				
Original or Resurvey				
Appearance of B.T.		poor	good	
Tags, Marks, etc.		no tag	no tag	

Other Remarks:

Cor ≈ 40' W of  
old rd. running NE

Steve Cole Forester,  
Abolley Ent.  
Signed

C. S. File No. 59/46-66