

T235 R5W

DATE: 3-28-78

$\frac{1}{4} \frac{6}{7}$

Condition Report Only  
 Not Found  
 Renewed  
 Unrecorded  
 Surveyed In  
 Referenced Out

Previous Renewal #'s #~~52~~<sup>53</sup>, CS 41/65 (SURVEY BY HAYDEN 1952)

Monument(s) Found: (Condition and Source) AT THE CORNER POINT WE FIND

THE FOLLOWING MONUMENTS:

FD: ROTTEN REMAINS OF A SCRIBED WOOD POST, APPROX. 3" X 3" (SOURCE UNKNOWN)

FD: A 1" AXLE WITH GEAR, FLUSH IN GROUND (SOURCE UNKNOWN)

$\frac{3}{4}$ " I. PIPE FOUND BY HAYDEN IN 1952 (CS 41/65) NOT FOUND.

FD: A 1" I. PIPE, EXTENDING 12" ABOVE GROUND, WITH BRASS CAP ATTACHED,

MARKED: COUNTY SURVEYOR'S OFFICE

T235 R5W

$\frac{1}{4} \frac{56}{57}$

1960

Accessories Found: (Condition and Source) AN ORIG. 44" FIR, NOW A 66"

STUMP (O.B.T.) WITH SCRIBING "BT" VISIBLE ON PREVIOUSLY OPENED

BLAZE BEARS S 54 $\frac{3}{4}$ ° W 13 $\frac{2}{4}$  FT.

ORIGINAL NE BT, AN 18" FIR NOT FOUND.

G.  
A 22" ~~BT~~ FIR (CS 41/65), ALIVE WITH WELL-HEALED DOUBLE  
BLAZE BEARS S 45° E 25 $\frac{2}{4}$  FT. (REC. 12" HEMLOCK S 40° E 25 $\frac{2}{4}$  FT.)

A 10" NOW 17" D. FIR (CS 41/65) ALIVE WITH WELL HEALED DOUBLE

#105 X

G. S. File No. 59/46-81 Page 1 of 1

C

BLAZE BEARS N 17° E 67<sup>1</sup>/<sub>2</sub> FT. (REC. N 21° E 67<sup>1</sup>/<sub>2</sub> FT.)

A 13" W. FIR, NOW AN 18" SNAG, WITH WELL-HEALED BLAZES BEARS  
N 88° W 18<sup>3</sup>/<sub>4</sub> (REN. # 53).

RENEWAL

Monument Set: (Procedure and Description) NONE

New Accessories: (Description) NONE

Location and Comments:

20° EAST

DOUGLAS CO. SURVEYOR'S OFFICE

GARY L. LANGRISH

Mary L. Langrish

FRANK C. SILAGY

Compass Declination

Agency

Party Chief

Notekeeper


Witnesses

OK  
*[Signature]*

#105  
#33  
59146

Section 6 Twp 23 S Rge 5 W

Date: 3-17-77

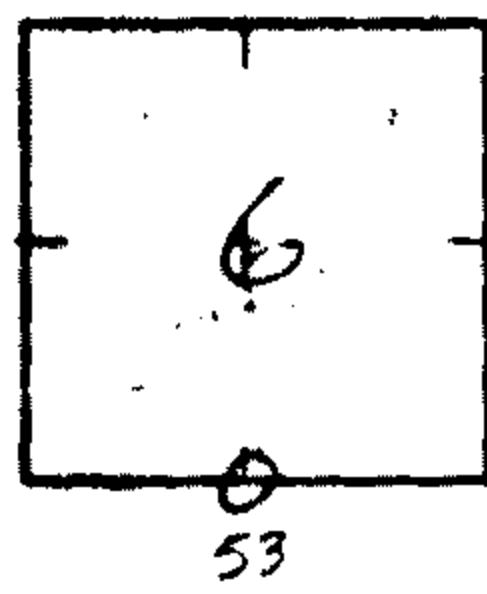

How was corner identified? Brass Cap (CS '66) + 2 BT's

Condition of corner: one BT dead

Best route to reach corner: W from Hayhurst rd.

Quadrant	NE	NW	SE	SW
Species & Size		18" GF snag	20" GF	
Dist. & Bearing		S88E, 18.3'	N45W, 25.9'	
Condition of Scribe				
Original or Resurvey				
Appearance of B.T.		dead	good	
Tags, Marks, etc.		loc. pester	loc. pester	

Other Remarks:

Corner on flat on  
reprod.

Steve Cole, Forester  
Woolley Ent  
C.S. No. 59146  
BI