

DATE: 5-1-78

T245

1/4 532 R1W
55

T255

Condition Report Only

Not Found

Renewed

Unrecorded

Surveyed In

Referenced Out

Previous Renewal #'s 97 IN T255, R1W #61-T24-1

Monument(s) Found: (Condition and Source) ^{1"x30"} A ~~1/2~~ IRON PIPE, ~~WITH~~ LYING ON THE GROUND OUT OF POSITION (REN #97) WITH BRASS CAP ATTACHED,

MARKED: COUNTY SURVEYOR'S OFFICE

T245
1/4 532 R
55 I
T255 W
1966

Accessories Found: (Condition and Source) ~~FE~~ THE ORIGINAL BEARING

TREES WERE FOUND AS FOLLOWS:

AN ORIG. 14" R. CEDAR, NOW A 17" SHATTERED STOB, 3 FT. TALL, SCRIBING

" 4 S" VISIBLE ON PREVIOUSLY OPENED BLAZE ON DOWNED PORTION OF THE

TREE LOCATED DOWNHILL FROM THE SHATTERED STUMP, BEARS N 43° W 5 ³/₄ FT.

AND AN ORIG. 36" D. FIG, NOW 40" AND UPROOTED WITH WELL HEALED BLAZE,

STUMP HOLE BEARS APPROX. S 74° E 18 ⁵/₈ FT.

#130 T24-1 X

#137 T25-1 X

C

FROM REN. *97: A 6" NOW 7" HEMLOCK, BLOWN DOWN BUT STILL ALIVE, WITH
SCRIBING "1/4 S 32 CS BT" VISIBLE ON UNHEALED DOUBLE BLAZE, BEARS
N 56 1/2° W 26 2/3 FT., (REC. N 52° W 26 2/3 FT.).

AND A 5" NOW 6" HEMLOCK, ALIVE WITH SCRIBING "1/4 S S CS BT"
VISIBLE ON UNHEALED DOUBLE BLAZE, BEARS S 44 1/2° E 32 5/8 FT.,
(REC. S 49° E 32 5/8 FT.).

RENEWAL

Monument Set: (Procedure and Description) AT A LOCATION WHICH AGREES
WITH THE MEASUREMENTS ~~IS~~ LISTED FOR THE PREVIOUSLY DESCRIBED
CORNER ACCESSORIES, WE RESET THE 1966 COUNTY SURVEYOR'S BRASS
CAP 28" IN THE GROUND ON A STEEP NORTH SLOPE, AND ADD THE
MARKINGS "RESET 1978" TO THE BRASS CAP.

New Accessories: (Description)

"A BOAT SPIKE MARKED "BO 1" SET NEAR THE HEART ON TOP OF A 54"
S. PINE STUMP BEARS S 87° W 32 3/8 FT.

Location and Comments:


CORNER IS LOCATED IN
CUT-OVER AREA.

20° EAST
DOUGLAS CO. SURVEYOR'S OFF.
GARY L. LANGLITZ
Gary L. Langlitz
FRANK C. JILAGY

Compass Declination
Agency
Party Chief
Notekeeper
Witnesses

OK
[Signature]

Section 5 Twp 25s Rge 1W W Date: 4/17/78

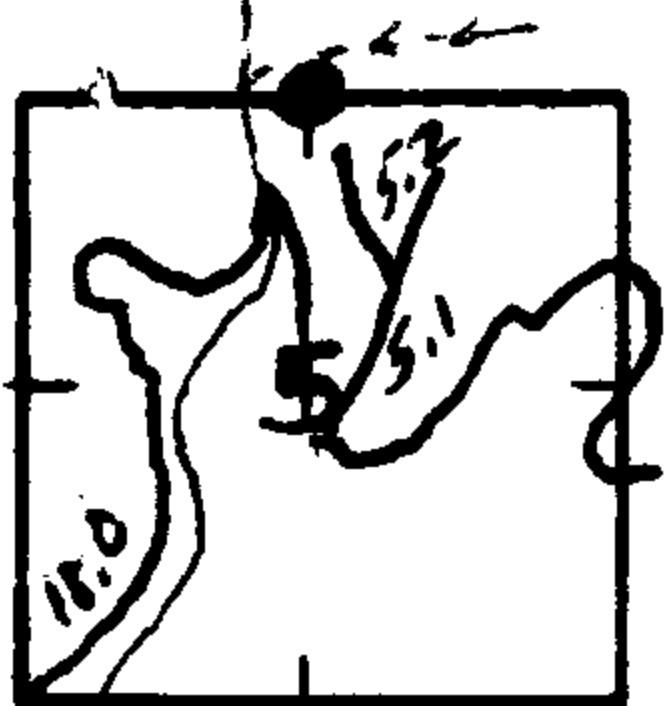

How was corner identified? CTY SURVEYORS OFFICE, B.C., 1966

3 B.T. IDENTIFIED - TWO OF THESE BLOWN DOWN.

Condition of corner: PIPE UP ROOTED & MOVED BY WINDTROWN TREE. PIPE & B.C. STILL INTACT, FLAGGED W/ SEVERAL FLUORESCENT PINK RIBBONS 3' LONG

Best route to reach corner: 18.0 ROAD TO 5.1 THEN LEFT ON LOWER 5.2 ROAD. WALK N. ON REST OF ROAD. CORNER IS S. SIDE OF E-W CREEK - BRUSHY AREA

Quadrant	NE	NW	SE	SW
Species & Size				
Dist. & Bearing				
Condition of Scribe				
Original or Resurvey				
Appearance of B.T.				
Tags, Marks, etc.				

Other Remarks:
LIKELY NEED 4WD
VEHICLE FOR 5.1 &
5.2 ROAD UNLESS VERY
DRY.
Geary Stab
Forster B.L.M.
 Signed