

DATE: 7-18-78

T295 R3W

$\frac{1}{4}$ $\frac{30}{31}$

Condition Report Only
 Not Found
 Renewed
 Unrecorded
 Surveyed In
 Referenced Out

Previous Renewal #'s NONE

Monument(s) Found: (Condition and Source) NONE

Accessories Found: (Condition and Source) THE ONLY REMAINING

BEARING TREE, AN ORIG. 40' ~~HIGH~~ D. FIR, NOW A 42" WINDFALL, WITH
ILLEGIBLE SCRIBE MARKS VISIBLE IN THE BARK ON A BURNT BLAZE
LOCATED ON THE UNDERSIDE OF THE TREE. THIS TREE BEARS
N. 57° W ⁸ FT., FROM THE CORNER POINT.

#1274

RENEWAL

Monument Set: (Procedure and Description) AT THE CORNER POINT, WE

SET A 1" X 30" I. PIPE, 27" IN THE GROUND, WITH BRASS CAP ATTACHED,

MARKED: DOUGLAS COUNTY SURVEYOR

T29S R3W

$\frac{1}{4}$ S30
S 31

1978

New Accessories: (Description) WE MARK THE FOLLOWING BT'S:

A 24" I. CEDAR WITH OLD LOCATION POSTER AND VARIOUS CRUISER'S MARKS

BEARS S 38° W 10² FT., SCRIBED "1/4 S 31 CS BT" ON A DOUBLE

BLAZE.

AND A 14" G. FIR, SCRIBED "1/4 S 30 CS BT" ON A DOUBLE BLAZE, BEARS

N 78° E 31² FT..

Location and Comments:

20° EAST.

Compass Declination

CORNER LOCATED APPROX.

DOUGLAS CO. SURVEYOR'S OFF.

Agency

GARY L. LANGLITZ

Party Chief

50 FT. NORTH OF AN EASTERLY

Gary L. Langlitz

Notekeeper

FLOWING CREEK AND APPROX.

FRANK C. SILAGY

Witnesses


300 FT. WEST OF A CREEK,

COURSE SOUTH.

OK
[Signature]

Section 30 Twp 29S Rge 3W N

Date: JUNE 29, 78

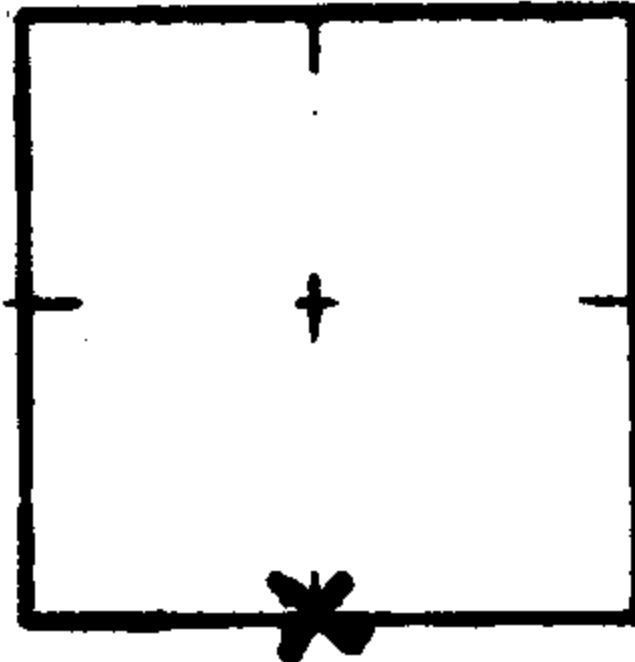

How was corner identified? OLD BT

Condition of corner: 1 BT Found E' IT IS a windfall with scribing on underside

Best route to reach corner: UP East side of Fate Creek then follow ribbons to corner.

Quadrant	NE	NW	SE	SW
Species & Size		40" Fir		
Dist. & Bearing		N57°W 30 lbs		
Condition of Scribe		barely visible		
Original or Resurvey		original		
Appearance of B.T.		windfall		
Tags, Marks, etc.		old tag on cedar with cruiser's		

Other Remarks:

scribing can best be identified with flashlight by looking underneath windfall.

Sw Hall

Signed

marks