


Index
File No. _____

CORNER RECORD (SEARCH)
(Ref. FSM 7151.4)

Tract or Survey No. _____ Cor. No. 68 - Douglas Co

T 20S R. 11W R.D. MAPLETON County Douglas
Merid. _____ N.F. Siuslaw State OR

CORNER DIAGRAM

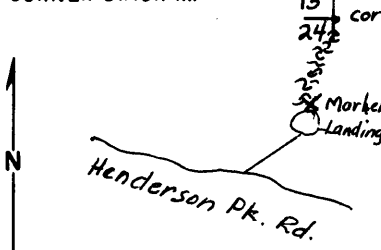

DESCRIBE CORNER MONUMENT FOUND

Sec. Cor 13 T20S R11W W.M. Douglas County
Pipe with brass cap #68 Douglas County
in mound of rock on steep rocky hillside

DESCRIBE BEARING TREES OR OTHER OFFICIAL ACCESSORIES FOUND

48" Fir stump w/tag S81°W 9.9'
30" Fir stump w/tag N74°W 8.6'
15" Cedar stump w/tag N50°W 16.6'

PHOTO IDENTIFICATION DATA

Photo No. _____
Filed At. _____
Object Ident. _____
Ident. By _____
Signature _____

PLANE COORDINATE POSITION DATA

State _____ Zone _____
X _____
Y _____
Estab. By _____
Agency _____

DESCRIBE CORNER LOCATION RELATIVE TO NEAR-BY FEATURES, ALSO HOW TO REACH CORNER

Starting at the junction of N.F.K Smith River and Henderson Pk Rds go toward Henderson Pk 1.5 mi to new spur road on Johnson Creek ridge, go up spur 500' to landing & marker on ridge at the landing follow ridge N 17°E 650 feet to cor 13/24

Signature _____

Title _____

Division _____

Headquarters _____

G.S. File No. 6011-37100-52-(3/68)

#63 T20-10 #118 T20-11

CORNER RECORD (PERPETUATION)

MONUMENT: DESCRIBE NEW MONUMENT SET, OR WORK DONE TO PRESERVE EXISTING MONUMENT

Drilled hole in rock ledge to receive the iron pipe and a recess was made for the brass cap and then cemented in place

9

ACCESSORIES : DESCRIBE NEW BT'S WITNESS OBJECTS ETC. ESTABLISHED, OR WORK DONE TO PRESERVE EXISTING EVIDENCE

None

10

Work Done By P. Fox Title Engineer Date 9/28/77 State Registration No. 3282
or Agency _____

Certified Cor. Record Prepared? Yes No Filed At: _____ Date _____

11

REMARKS

Index File No. T. R. M. Tract or Surv. No. Cor. _____

12

13